

MISSISSIPPI
BOARD OF WATER COMMISSIONERS
416 North State Street
Jackson, Mississippi 39201

CODED

WATER WELL DRILLERS LOG

Le flare
D25
2-67

Feb 3 1967 *Butane Gas of Greenwood* *Le flare*
date well completed firm name county well located

LANDOWNER:

Jack Tillman

Rt 1 - Minter City, Miss
(mailing address)

description of formations encountered

from to

WELL LOCATION:


sec 7 T 21 N R 1 E
S W
7 miles SW of Minter City
(distance) (direction) (nearest town)

WELL PURPOSE: Home
(home, irrigation, municipal, industrial)

WELL COMPLETION DATA:


- (1) diameter (inches) 4" x 2 1/2" x 2"
- (2) total depth (feet) 933'
- (3) static water level (feet) _____ ^{below}/_{above} top of ground
- (4) casing 4" - 105' / 2 1/2" - 798'
(material) (depth)
- 4" x 2 1/2" if telescope see back.
(size)
- (5) screen 30' / 903'
(length) (depth to top)
- 2" / Stainless Steel
(size) (material)
- (6) pump 1 / 10
(HP) (yield gpm)
- Electric
(type power)
- (7) electric log No
(yes or no)
- _____
(organization running log)
- (8) how well bottom plugged _____
Basic Pressure Valve

CODED
Hard Packed Sand *895 941*

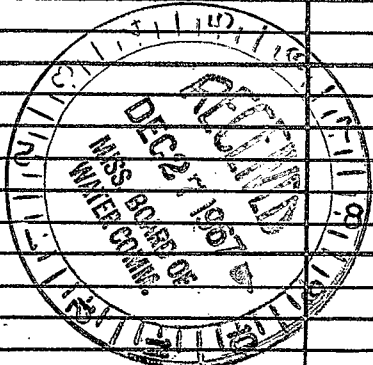

DRILLERS REMARKS:

If well telescopes please sketch and show depths.

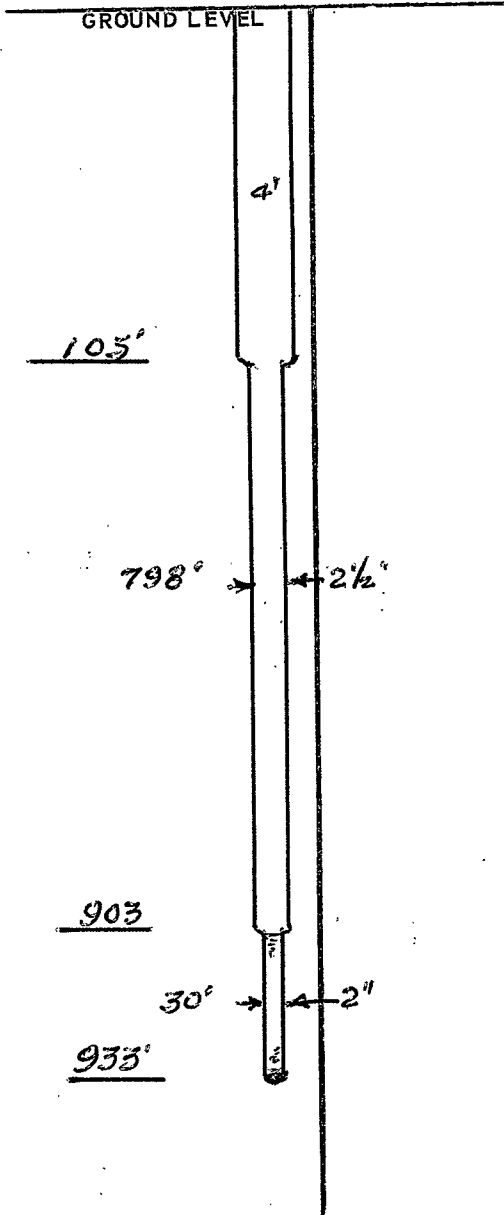

X			

SECTION 7

Please indicate well location X.

ADDITIONAL INFORMATION

If more than one screen, show locations of each on sketch.