

LeFlore
D27
3-67

MISSISSIPPI
BOARD OF WATER COMMISSIONERS
416 North State Street
Jackson, Mississippi 39201, **CODED**

WATER WELL DRILLERS LOG

3/31/67 19 BUTANE GAS CO GREENWOOD LEFLORE
date well completed film name county well located

LANDOWNER:
LUTHER WADE
Box 288 Greenwood, Miss
(mailing address)

description of formations encountered	from	to
<u>TOP SOIL</u>	<u>0</u>	<u>18</u>
<u>FINE SAND</u>	<u>18</u>	<u>45</u>
<u>COARSE SAND & GRAVEL</u>	<u>45</u>	<u>100</u>

WELL LOCATION:
sec. 9 T 21 N R. 1 E
5 W
1/2 miles East of Springside
(distance) (direction) (nearest town)


WELL PURPOSE: IRRIGATION
(home, irrigation, municipal, industrial)

CODED

- WELL COMPLETION DATA:
- (1) diameter (inches) 6"
 - (2) total depth (feet) 100'
 - (3) static water level (feet) 19 below ~~base~~ top of ground.
 - (4) casing Black - 60
(material) (depth)
6 if telescope see back.
(size)
 - (5) screen 40 60'
(length) (depth to top)
6" BLACK STEEL
(size) (material)
 - (6) pump 15 1000
(HP) (yield gpm)
Tractor
(type power)
 - (7) electric log No
(yes or no)

(organization running log)
 - (8) how well bottom plugged STEEL PLATE

DRILLERS REMARKS:

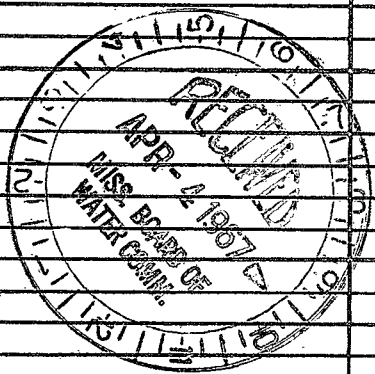

If well telescopes please sketch and show depths.

GROUND LEVEL

		X	

SECTION 9

Please indicate well location X.

ADDITIONAL INFORMATION

If more than one screen, show locations of each on sketch.