

LEFLORE  
 D37  
 3-68

MISSISSIPPI  
 BOARD OF WATER COMMISSIONERS  
 416 North State Street  
 Jackson, Mississippi 39201  
 WATER WELL DRILLERS LOG

CODED

3-6-68 date well completed  
 19 Butane Gas Co. of Greenwood firm name  
 Leflore county well located

LANDOWNER:  
 L. W. Wade Planting Co.  
 Minter City, Miss.  
 (mailing address)

description of formations encountered	from	to
CLAY	0	10
SAND	10	60
SAND & GRAVEL	60	86


WELL LOCATION:  
 sec. 9 T 21 N R. 1 E W  
 5 1/2 miles S of Minter City  
 (distance) (direction) (nearest town)

WELL PURPOSE: Home  
 (home, irrigation, municipal, industrial)

WELL COMPLETION DATA:

- (1) diameter (inches) 2"
- (2) total depth (feet) 86'
- (3) static water level (feet) 18' below top of ground.
- (4) casing Steel, 76' (material) (depth)  
 2" (size) If telescope see back.
- (5) screen 10' 76' (length) (depth to top)  
 2" PVC (size) (material)
- (6) pump 3/4 (HP) 5 (yield gpm)  
 Elec. (type power)
- (7) electric log NO (yes or no)  
 (organization running log)
- (8) how well bottom plugged BACK WASH VALVE

CODED

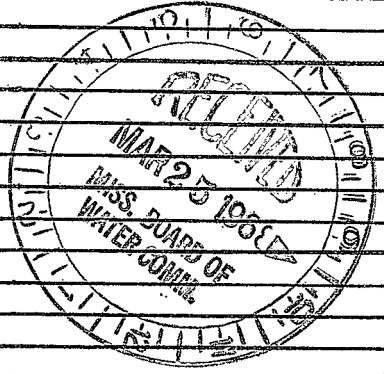

DRILLERS REMARKS:

If well telescopes please sketch and show depths.

GROUND LEVEL

		X	

SECTION \_\_\_\_\_

Please indicate well location X.

ADDITIONAL INFORMATION

If more than one screen,  
show locations of each on sketch.