

LEFLORE  
D38  
6/6/78  
1

MISSISSIPPI  
BOARD OF WATER COMMISSIONERS  
416 North State Street  
Jackson, Mississippi 39201

CODED

WATER WELL DRILLERS LOG  
BUTANE GAS COMPANY  
OF GREENWOOD  
firm name

Leflore

6-6-78 19  
date well completed

county well located

LANDOWNER:	description of formations encountered	from	to
BROWN FARMS			
Schlater	Sand & Pea Gravel	50	90
(mailing address)	Sand	90	100
WELL LOCATION:	Rock	100	
sec. 33 T 21 N R 1 E S 5 W			
2 miles E of Schlater			
(distance) (direction) (nearest town)			
WELL PURPOSE: Irr			
(home, irrigation, municipal, industrial)			
WELL COMPLETION DATA:			
(1) diameter (inches) 16			
(2) total depth (feet) 100			
(3) static water level (feet) 20 below above top of ground.			
(4) casing Steel 60 (material) (depth)			
16" (size) if telescope see back.			
(5) screen 40 60 (length) (depth to top)			
16 (size) Steel (material)			
(6) pump 60 650 (HP) (yield gpm)			
Diesel (type power)			
(7) electric log NO (yes or no)			
(organization running log)			
(8) how well bottom plugged Steel Plate			
DRILLERS REMARKS:			


CODED

RECEIVED  
JUN 14 1978

MISS. BD. OF WATER COMMISSIONERS

If well telescopes please sketch and show depths.

GROUND LEVEL

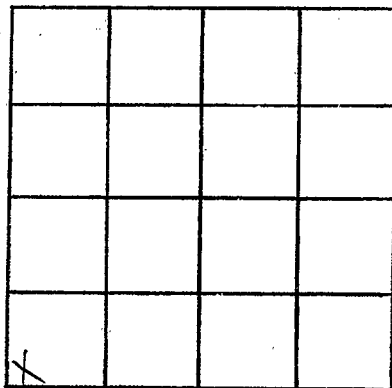

SECTION \_\_\_\_\_

Please indicate well location X.

ADDITIONAL INFORMATION

If more than one screen,  
show locations of each on sketch.