

LEFLORE
D39
6/27/78

MISSISSIPPI
 BOARD OF WATER COMMISSIONERS
 416 North State Street
 Jackson, Mississippi 39201

WATER WELL DRILLERS LOG
 BUTANE GAS COMPANY
 OF GREENWOOD

CODED

6-27-78 19
 date well completed

LeFlore
 county well located

LANDOWNER:
BROWN FARMS
Schlater
 (mailing address)

description of formations encountered	from	to
SAND	0	31
SAND + Pea Gravel	31	40
SAND + Gravel	40	80
SAND	80	100

WELL LOCATION:
 sec. 32 T 21 N R 1 E
 & W
1 miles E of Schlater
 (distance) (direction) (nearest town)

WELL PURPOSE: IRR.
 (home, irrigation, municipal, industrial)

CODED

WELL COMPLETION DATA:

(1) diameter (inches) 16"

(2) total depth (feet) 100

(3) static water level (feet) 20 below above top of ground.

(4) casing Steel 60,
 (material) (depth)
16" If telescope see back.
 (size)

(5) screen 40 60
 (length) (depth to top)
16" Steel
 (size) (material)

(6) pump 40 1800
 (HP) (yield gpm)
Diesel
 (type power)

(7) electric log No
 (yes or no)

(organization running log)

(8) how well bottom plugged
Steel Plate

RECEIVED


JUL - 7 1978

DRILLERS REMARKS:

MISS. Bd. OF WATER COMMISSIONERS

If well telescopes please sketch and show depths.

GROUND LEVEL

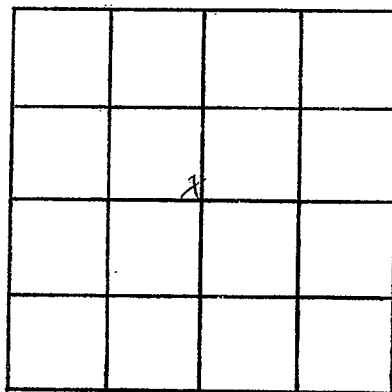

SECTION 32

Please indicate well location X.

ADDITIONAL INFORMATION

A series of horizontal lines for writing additional information, starting below the 'ADDITIONAL INFORMATION' header and extending down to the bottom of the page.

If more than one screen, show locations of each on sketch.