

LEFLORE
D40
4/26/78

MISSISSIPPI
BOARD OF WATER COMMISSIONERS
416 North State Street
Jackson, Mississippi 39201

CODED

WATER WELL DRILLERS LOG

April 26, 1978 Bruce Berryman Leflore
date well completed firm name county well located
Greenwood.


LANDOWNER:	description of formations encountered	from	to
Jimmy Cole	Clay	0	20
Schlater,	Sand	20	60
MS. 38952	Sand & Gravel	60	120
(mailing address)	Clay	120	240
WELL LOCATION:	Sand	240	280
sec. 19 T 21 N R 1 E	Clay	280	300
2 1/2 miles N of Schlater	Sand	300	320
(distance) (direction) (nearest town)	Shale	320	360
WELL PURPOSE: Home	Clay	360	380
(home, irrigation, municipal, industrial)	Shale & Str. sand	380	400
WELL COMPLETION DATA:	Rock & shale	400	420
(1) diameter (inches) 4" x 2"	Sand	420	440
(2) total depth (feet) 945'	Shale	440	480
(3) static water level (feet) 3' below top of ground	Rock & shale	480	500
(4) casing 2" blk. galv. - 126'	Green sand	500	550
(material) (depth) 2" galv. - 798'	Shale	550	590
(size) if telescope see back.	Sand	590	620
(5) screen 20' 925'	Shale	620	660
(length) (depth to top)	Brown sand	660	680
.010 stainless steel	Sand & Str shale	680	700
(size) (material)	Sand	700	740
(6) pump 1 30	Clay	740	780
(HP) (yield gpm)	Sand & str shale	780	840
Electric	Shale	840	900
(type power)	White sand	900	950
(7) electric log No			
(yes or no)			
(organization running log)			
(8) how well bottom plugged B.P.V.			
DRILLERS REMARKS:			

RECEIVED
NOV - 7 1978

MISS. BD. OF WATER COMMISSIONERS

If well telescopes please sketch and show depths.

GROUND LEVEL

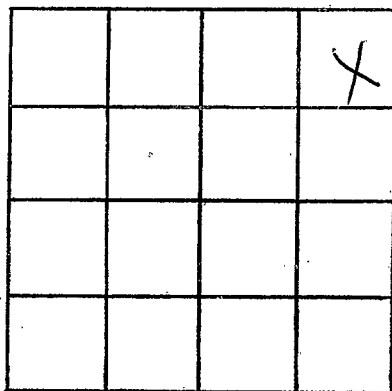

SECTION 19

Please indicate well location X.

ADDITIONAL INFORMATION

If more than one screen,
show locations of each on sketch.