

LEFLORE
 D 41
 5/21/79

MISSISSIPPI
 BOARD OF WATER COMMISSIONERS
 416 North State Street
 Jackson, Mississippi 39201

CODED

WATER WELL DRILLERS LOG
 BUTANE GAS COMPANY

5/21/79
 date well completed

Leflore
 county well located

OF GREENWOOD

LANDOWNER: W.R. Webb
 Sunny Side FARMS
 Minter City
 (mailing address)

description of formations encountered	from	to
Clay	0	18
SAND	18	30
SAND + Pea Gravel	30	60
SAND + GRAVEL	60	100

WELL LOCATION:
 sec. 13 T. 21 N R. 1 E
 S W
 3 miles NW of Money
 (distance) (direction) (nearest town)

WELL PURPOSE:
 (home, irrigation, municipal, industrial)

WELL COMPLETION DATA:
 (1) diameter (inches) 12"
 (2) total depth (feet) 100
 (3) static water level (feet) 18 below above top of ground.
 (4) casing Steel, 60
 (material), (depth)
12" if telescope see back.
 (size)
 (5) screen 40, 60
 (length), (depth to top)
12", Steel
 (size), (material)
 (6) pump 30, 1200
 (HP), (yield gpm)
LPG
 (type power)
 (7) electric log NO
 (yes or no)
 (organization running log)
 (8) how well bottom plugged Steel Plate

Miss. Board of Water Comm.


JUN - 8 1979

RECEIVED

DRILLERS REMARKS:

If well telescopes please sketch and show depths.

GROUND LEVEL

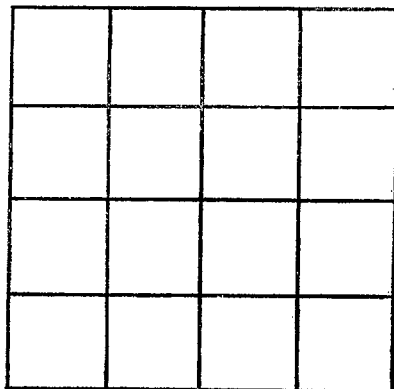

SECTION _____

Please indicate well location X:

ADDITIONAL INFORMATION

If more than one screen,
show locations of each on sketch.