

LEFLORE
D43
6-2-81

MISSISSIPPI DEPARTMENT OF NATURAL RESOURCES
Bureau of Land and Water Resources
Southport Mall
P.O. Box 10631 CODED
Jackson, Mississippi 39209
WATER WELL DRILLERS LOG

6-2-81
date well completed

1981

BUTANE GAS COMPANY
OF GREENWOOD

Leflore
county well located

LANDOWNER:	description of formations encountered	from	to
Conway Farms	Clay	0	15
Fletcher	Sand	15	45
(mailing address)	Sand & Pea Gravel	45	55
WELL LOCATION:	Sand and Gravel	55	100
sec. 9 T 21 N R 1 E 8 W 3 miles S of Minter City (distance) (direction) (nearest town)			
WELL PURPOSE: Domestic (home, irrigation, municipal, industrial)			
WELL COMPLETION DATA:			
(1) diameter (inches) 16"			
(2) total depth (feet) 100			
(3) static water level (feet) 25 below top of ground.			
(4) casing Steel, 60 (material) (depth)			
16 if telescope see back. (size)			
(5) screen 40, 60 (length) (depth to top)			
16", Steel (size) (material)			
(6) pump 50, 2000 (HP) (yield gpm)			
Diesel (type power)			
(7) electric log No (yes or no)			
(organization running log)			
(8) how well bottom plugged Steel Plate			
DRILLERS REMARKS:			


CODED

DEPT. OF NATURAL RESOURCES
BUREAU OF LAND & WATER RESOURCES

JUN 15 1981
RECEIVED

If well telescopes please
sketch and show depths.

GROUND LEVEL

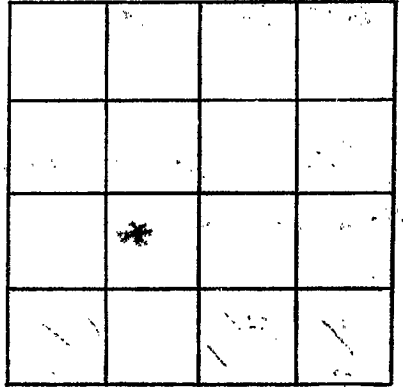

SECTION 7

Please indicate well location X.

ADDITIONAL INFORMATION

If more than one screen,
show locations of each on sketch.