

LEFLORE
D 44
6-3-81

MISSISSIPPI DEPARTMENT OF NATURAL RESOURCES
Bureau of Land and Water Resources
Southport Mall
P.O. Box 10631
Jackson, Mississippi 39209
WATER WELL DRILLERS LOG

CODED

6-3-81 date well completed 1981 BUTANE GAS COMPANY Leflore OF GREENWOOD county well located

LANDOWNER: Conway Farms
(mailing address)

description of formations encountered	from	to
Clay	0	15
SAND	15	30
Sand & Pea Gravel	30	50
Sand & Gravel	50	100
Fine Sand	100	

WELL LOCATION:
sec. 9 T 21 N R 1 E W
2.5 miles S of Winter Cove
(distance) (direction) (nearest town)

WELL PURPOSE: Irrigation
(home, irrigation, municipal, industrial)

- WELL COMPLETION DATA:
- (1) diameter (inches) 16"
 - (2) total depth (feet) 100
 - (3) static water level (feet) 25 below top of ground.
 - (4) casing Steel 60 (material), (depth)
16 (size) if telescope see back.
 - (5) screen 40 60 (length), (depth to top)
16" Steel (size), (material)
 - (6) pump 50 1000 (HP), (yield gpm)
Diapal (type power)
 - (7) electric log (yes or no)
 - (organization running log)
 - (8) how well bottom plugged
Steel Plate

CODED

DEPT. OF NATURAL RESOURCES
BUREAU OF LAND & WATER RESOURCES


JUN 15 1981

RECEIVED

DRILLERS REMARKS:

If well telescopes please sketch and show depths.

GROUND LEVEL

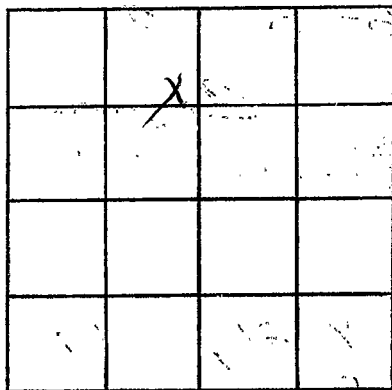

SECTION 9

Please indicate well location X.

ADDITIONAL INFORMATION

If more than one screen,
show locations of each on sketch.