

MISSISSIPPI DEPARTMENT OF NATURAL RESOURCES

Bureau of Land and Water Resources

Southport Mall

P.O. Box 10631

Jackson, Mississippi 39209

CODED

Leflore
D 45
8-4-81

BUTANE GAS WATER OF GREEN WELLS DOG


8-4 1981 date well completed Leflore firm name Leflore county well located

LANDOWNER:	description of formations encountered	from	to
<u>Conway Farms</u>			
<u>Sunnyvale Ms.</u> (mailing address)	<u>fine sand</u>	<u>20</u>	<u>35</u>
	<u>sand</u>	<u>35</u>	<u>40</u>
WELL LOCATION: sec. <u>8</u> T <u>21</u> N R <u>1</u> E <u>3/4</u> miles <u>NW</u> of <u>Sunnyvale</u> (distance) (direction) (nearest town)	<u>Sand + p. gravel</u>	<u>40</u>	<u>50</u>
	<u>Sand - p. gravel + sand</u>	<u>50</u>	<u>60</u>
	<u>Sand + fine sand</u>	<u>60</u>	<u>70</u>
	<u>sand + gravel</u>	<u>70</u>	<u>80</u>
	<u>sand + gravel fine sand</u>	<u>80</u>	<u>90</u>
	<u>Sand + gravel</u>	<u>90</u>	<u>100</u>
	<u>rock clay</u>	<u>100</u>	
	WELL PURPOSE: <u>irrigation</u> (home, irrigation, municipal, industrial)		

- WELL COMPLETION DATA:
- (1) diameter (inches) 16"
 - (2) total depth (feet) 100'
 - (3) static water level (feet) 30 below above
top of ground.
 - (4) casing Steel, 60
(material) (depth)
16" if telescope see back.
(size)
 - (5) screen 40', 60
(length) (depth to top)
16", steel
(size) (material)
 - (6) pump 60, 1000
(HP) (yield gpm)
Diexel
(type power)
 - (7) electric log No
(yes or no)

(organization running log)
 - (8) how well bottom plugged
steel plate

CODED

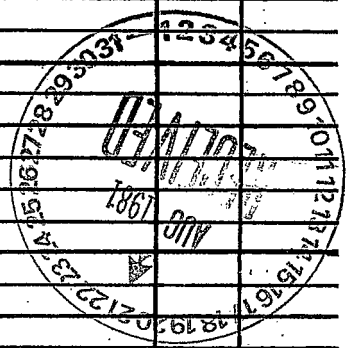

DRILLERS REMARKS:

If well telescopes please sketch and show depths.

GROUND LEVEL

Handwritten notes and sketches on the left side of the page, including vertical lines and illegible text.

	X		

SECTION 8

Please indicate well location X.

ADDITIONAL INFORMATION

Multiple horizontal lines for additional information.

If more than one screen, show locations of each on sketch.