

MISSISSIPPI DEPARTMENT OF NATURAL RESOURCES

Bureau of Land and Water Resources

Southport Mall

P.O. Box 10631

Jackson, Mississippi 39209

WATER WELL DRILLERS LOG

CODED

Leflore
D46
7/12/81

7/12/81 19 Superwell - 2nd Sec Leflore
date well completed firm name county well located

LANDOWNER: Kramer Investment
P.O. Box 926
Aberdeen, MS 39730
(mailing address)

| description of formations encountered | from | to |
|---------------------------------------|------|-----|
| Clay | 0 | 28 |
| Sand | 28 | 36 |
| Sand & Gravel | 36 | 102 |

WELL LOCATION:
sec. 22 T 21 (N) R 1 (E)
S (W)
4 miles NB of Schlater
(distance) (direction) (nearest town)

WELL PURPOSE:
(home, irrigation, municipal, industrial)

WELL COMPLETION DATA:

(1) diameter (inches) 16

(2) total depth (feet) 102

(3) static water level (feet) 23 below top of ground.

(4) casing Steel 62'
(material) (depth)
16 (size) if telescope see back.

(5) screen 40', 62'
(length) (depth to top)
16 (size) Steel (material)


(6) pump 180 3000
(HP) (yield gpm)
Electric (type power)

(7) electric log No
(yes or no)

(organization running log)

(8) how well bottom plugged Plate


CODED

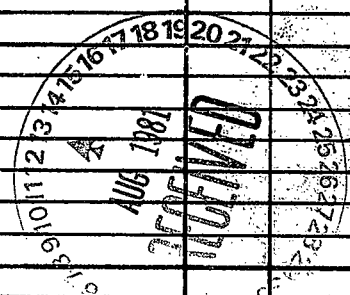

DRILLERS REMARKS:

If well telescopes please sketch and show depths.

GROUND LEVEL

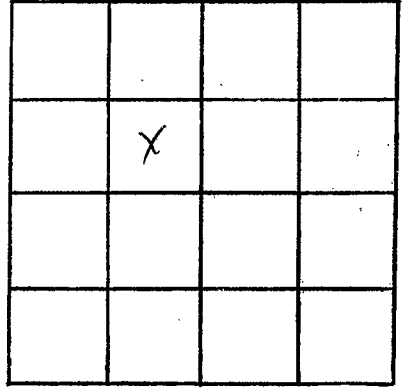

SECTION 22

Please indicate well location X.

ADDITIONAL INFORMATION

If more than one screen,
show locations of each on sketch.