

MISSISSIPPI DEPARTMENT OF NATURAL RESOURCES

Bureau of Land and Water Resources

Southport Mall

P.O. Box 10631

Jackson, Mississippi 39200

WATER WELL DRILLERS LOG

CODED

LEFLORE
D 48
4112183

John Patton Chesnut

4-12-83

19

Irrigation Equipment, Inc.

LeFlore

date well completed

firm name

county well located

LANDOWNER: WALKER BROS. FARMS

P. O. BOX 202

SCHLATER, MS 38952

(mailing address)

WELL LOCATION:

sec. 11 T. 21 N. S.

R. 2 E. W.

0.5 miles north of Schlater
(distance) (direction) (nearest town)

WELL PURPOSE: irrigation
(home, irrigation, municipal, industrial)

WELL COMPLETION DATA:

- (1) diameter (inches) 16
- (2) total depth (feet) 110
- (3) static water level (feet) 33 below above top of ground.
- (4) casing steel, 70 (material), (depth), (size) if telescope see back.
- (5) screen 40, 70'-110' (length), (depth to top) 16" steel (size), (material)
- (6) pump 80, 1600 (HP), (yield gpm) diesel (type power)
- (7) electric log (yes or no) (organization running log)
- (8) how well bottom plugged steel plate

description of formations encountered

from

to

Gumbo	0	23
Blue clay	23	40
Coarse gravel & clay	40	55
Fine sand & coarse gravel	55	70
Coarse sand & fine gravel	70	100
Coarse gravel	100	110

CODED

DEPT. OF NATURAL RESOURCES
BUREAU OF LAND & WATER RESOURCES


MAY 9 - 1983

RECEIVED

DRILLERS REMARKS:

If well telescopes please sketch and show depths.

GROUND LEVEL

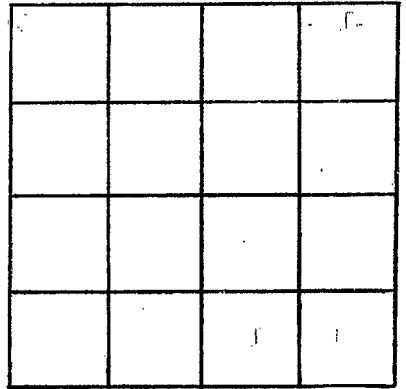

SECTION _____

Please indicate well location X.

ADDITIONAL INFORMATION

If more than one screen,
show locations of each on sketch.