

MISSISSIPPI DEPARTMENT OF NATURAL RESOURCES

Bureau of Land and Water Resources

Southport Mall

P.O. Box 10631

Jackson, Mississippi 39209 **CODED**

WATER WELL DRILLERS LOG

*Jelm Patton Chem*  
Irrigation Equipment, Inc.

LE FLORE  
D49  
4/18/83

4-18-83 date well completed 19 Irrigation Equipment, Inc. firm name LeFlore county well located

LANDOWNER: Walker Bros. Farm P. O. Box 202 Schlater, MS 38952 (mailing address)	description of formations encountered	from	to
	Gumbo	0	22
	Blue clay	22	39
	Clay & coarse gravel	39	55
	Fine sand	55	63
	Coarse sand & gravel	63	100
	Gumbo	100	105
WELL LOCATION: sec. <u>14</u> T. <u>21</u> N. R. <u>8</u> E. <u>1E</u> S W			
<u>5</u> miles <u>north</u> of <u>Schlater</u> (distance) (direction) (nearest town)			
WELL PURPOSE: <u>Irrigation</u> (home, irrigation, municipal, industrial)			
WELL COMPLETION DATA:			
(1) diameter (inches) <u>16</u>			
(2) total depth (feet) <u>105</u>			
(3) static water level (feet) <u>33</u> <sup>below</sup> <del>above</del> top of ground.			
(4) casing <u>steel</u> <u>60</u> (material) (depth)			
(size) If telescope see back.			
(5) screen <u>40'</u> <u>60'-100'</u> (length) (depth to top)			
<u>16"</u> <u>steel</u> (size) (material)			
(6) pump <u>80</u> <u>1600</u> (HP) (yield gpm)			
<u>diesel</u> (type power)			
(7) electric log (yes or no) _____			
(organization running log) _____			
(8) how well bottom plugged <u>steel</u> <u>plate</u>			
DRILLERS REMARKS: _____			

CODED


DEPT. OF NATURAL RESOURCES  
BUREAU OF LAND & WATER RESOURCES

MAY 9 - 1983

RECEIVED

If well telescopes please sketch and show depths.

GROUND LEVEL

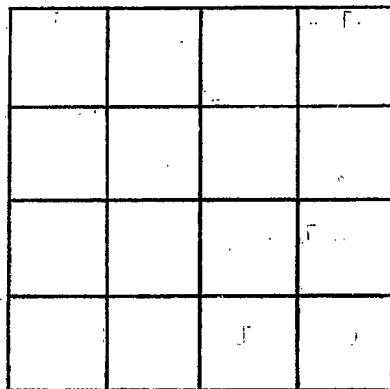

SECTION \_\_\_\_\_

Please indicate well location X.

**ADDITIONAL INFORMATION**

If more than one screen,  
show locations of each on sketch.