

MISSISSIPPI DEPARTMENT OF NATURAL RESOURCES

Bureau of Land and Water Resources

Southport Mall

P.O. Box 10631

Jackson, Mississippi 39209

WATER WELL DRILLERS LOG

CODED

LEFLORE
D 50
4/5/83

John Patton

4-5-83 19 Irrigation Equipment, Inc. LeFlore
date well completed firm name county well located

LANDOWNER: WALKER BROS. FARM	description of formations encountered		from	to
P. O. Box 202	Brown Clay		0	25
Schlater, MS 38952 (mailing address)	Blue clay		25	40
WELL LOCATION:	Coarse sand		40	55
sec. 13 T 21 S R 2 E ^{1 W}	Coarse sand & gravel		55	100
5 miles north of Schlater (distance) (direction) (nearest town)				
WELL PURPOSE: irrigation (home, irrigation, municipal, industrial)				
WELL COMPLETION DATA:				
(1) diameter (inches) 16				
(2) total depth (feet) 100				
(3) static water level (feet) 33 ^{below} above top of ground.				
(4) casing steel, 60 (material) (depth)				
16" If telescope see back. (size)				
(5) screen 40', 60-100' (length) (depth to top)				
16" steel (size) (material)				
(6) pump 80 1600 (HP) (yield gpm)				
diesel (type power)				
(7) electric log (yes or no)				
(organization running log)				
(8) how well bottom plugged steel plate				

CODED

RECEIVED


MAY 9 - 1983

DEPT. OF NATURAL RESOURCES
BUREAU OF LAND & WATER RESOURCES

DRILLERS REMARKS:

If well telescopes please sketch and show depths.

GROUND LEVEL

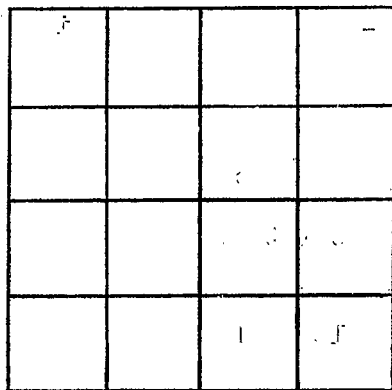

SECTION _____

Please indicate well location X.

ADDITIONAL INFORMATION

If more than one screen, show locations of each on sketch.