

MISSISSIPPI DEPARTMENT OF NATURAL RESOURCES

Bureau of Land and Water Resources

Southport Mall

P.O. Box 10631

Jackson, Mississippi 39209

CODED

WATER WELL DRILLERS LOG

BUTANE GAS CO. OF GREENWOOD

POST OFFICE BOX 1138

GREENWOOD, MISS. 389 county well located

Leflore
D 54

3-11-82
date well completed

LANDOWNER:
Brown Farms
(mailing address)

description of formations encountered	from	to
<i>Clay</i>	<i>0</i>	<i>20</i>
<i>Clay + Sand</i>	<i>20</i>	<i>55</i>
<i>gravel</i>	<i>55</i>	<i>95</i>

WELL LOCATION:
sec. *32* T *20* N R. *1* E
1 miles *E* of *Sallate*
(distance) (direction) (nearest town)

WELL PURPOSE: *irrigation*
(home, irrigation, municipal, industrial)

- WELL COMPLETION DATA:
- (1) diameter (inches) *16"*
 - (2) total depth (feet) *95*
 - (3) static water level (feet) *17* below top of ground.
 - (4) casing *Steel*, *62'*
(material) (depth)
16" if telescope see back.
(size)
 - (5) screen *32*, *62'*
(length) (depth to top)
16, *steel*
(size) (material)
 - (6) pump *120*, *1500*
(HP) (yield gpm)
Diesel
(type power)
 - (7) electric log *No*
(yes or no)
No
(organization running log)
 - (8) how well bottom plugged
Steel plate

DRILLERS REMARKS:
Done


DEPT. OF NATURAL RESOURCES
BUREAU OF LAND AND WATER RESOURCES

MAR 29 1982

RECEIVED

If well telescopes please
sketch and show depths.

GROUND LEVEL

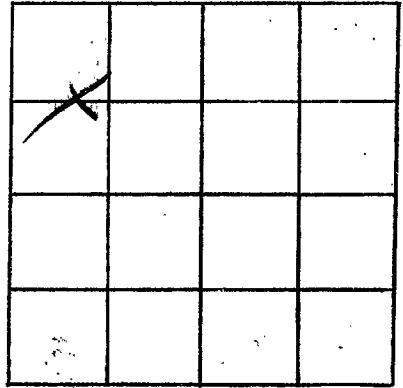

SECTION 32

Please indicate well location X.

ADDITIONAL INFORMATION

If more than one screen,
show locations of each on sketch.