

MISSISSIPPI DEPARTMENT OF NATURAL RESOURCES

Bureau of Land and Water Resources

Southport Mall

P.O. Box 10631

Jackson, Mississippi 39209

WATER WELL DRILLERS LOG

CODED

Lefflore
D 55

19 date well completed

Super Well Inc firm name

Lefflore county well located

LANDOWNER: *Miller Bank*

description of formations encountered

from

to

Clay
Sand Gravel

0

41

41

102

(mailing address)

WELL LOCATION:

sec *33* T *21* (N) S R *1* E (W) W
4 miles *E* of *Schlate*
(distance) (direction) (nearest town)

WELL PURPOSE:

(home, (irrigation), municipal, industrial)

WELL COMPLETION DATA:

- (1) diameter (inches) *16"*
- (2) total depth (feet) *102*
- (3) static water level (feet) *15* below above top of ground.
- (4) casing *Steel*, *62*,
(material) (depth)

 if telescope see back.
(size)

- (5) screen *40'*, *40'*
(length) (depth to top)
- 16*, *steel*
(size) (material)

- (6) pump *80*, *1200*
(HP) (yield gpm)

diesel
(type power)

- (7) electric log *no*
(yes or no)

no
(organization running log)

- (8) how well bottom plugged *plate*

DRILLERS REMARKS:


DEPT. OF NATURAL RESOURCES
BUREAU OF LAND & WATER RESOURCES

FEB - 3 1983

RECEIVED

If well telescopes please sketch and show depths.

GROUND LEVEL

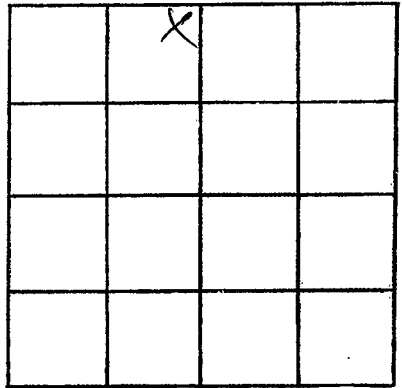

SECTION 33

Please indicate well location X.

ADDITIONAL INFORMATION

If more than one screen,
show locations of each on sketch.