

MISSISSIPPI DEPARTMENT OF NATURAL RESOURCES

Bureau of Land and Water Resources

Southport Mall

P.O. Box 10631

Jackson, Mississippi 39209 CODED

WATER WELL DRILLERS LOG

Leflore
D 56

date well completed 19

firm name

county well located

Dyer Well - Irving Leflore

LANDOWNER: Miller Bush

description of formations encountered

from

to

(Big O)

(mailing address)

Clay
fine sand
sand
sand & gravel

0	12
14	40
40	50
50	108

WELL LOCATION:

sec. 28 T 21 (N) R 1 E
3 miles NE of Shlater
(distance) (direction) (nearest town)

WELL PURPOSE:
(home irrigation, municipal, industrial)

WELL COMPLETION DATA:

- (1) diameter (inches) 16
- (2) total depth (feet) 105
- (3) static water level (feet) 65 below above top of ground.
- (4) casing Steel, 65,
(material) (depth)

if telescope see back.
(size)

- (5) screen 40', 40'
(length) (depth to top)
16, steel
(size) (material)

- (6) pump 80 1200
(HP) (yield gpm)
diesel
(type power)

- (7) electric log no
(yes or no)

(organization running log) no

- (8) how well bottom plugged plugged

DRILLERS REMARKS:


DEPT. OF NATURAL RESOURCES
BUREAU OF LAND & WATER RESOURCES

FEB - 3 1983

RECEIVED

If well telescopes please sketch and show depths.

GROUND LEVEL

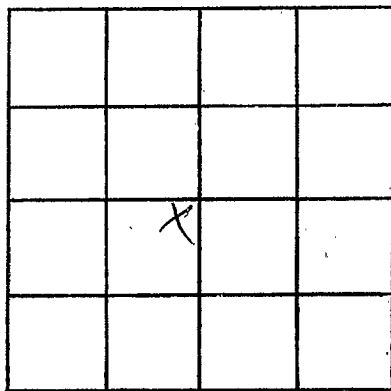

SECTION 28

Please indicate well location X.

ADDITIONAL INFORMATION

If more than one screen,
show locations of each on sketch.