

MISSISSIPPI DEPARTMENT OF NATURAL RESOURCES

Bureau of Land and Water Resources

Southport Mall

P.O. Box 10631

Jackson, Mississippi 39209

WATER WELL DRILLERS LOG

D57  
LeFlore Co  
6-7-84

CODED

LeFlore

6-2-84

JHK Irrigation well

LeFlore

date well completed

firm name

county well located

LANDOWNER:

Greenwood Irrigation

(mailing address)

WELL LOCATION:

sec 5 T 21 N R 1 E  
S W  
1 miles NW of Sumner Mo  
(distance) (direction) (nearest town)

description of formations encountered

from to

CLAY

0 22

FINE SAND

22 41

SAND GRAVEL

41 103

WELL PURPOSE:

(home, irrigation, municipal, industrial)

CODED

WELL COMPLETION DATA:

- (1) diameter (inches) 12
- (2) total depth (feet) 103
- (3) static water level (feet) 28' below top of ground.
- (4) casing steel, 63 (material), (depth)
- 12 (size) if telescope see back.
- (5) screen 40, 63 (length), (depth to top)
- 12, steel (size), (material)
- (6) pump 80, 1400 (HP), (yield gpm)
- diesel (type power)
- (7) electric log no (yes or no)

(organization running log)

(8) how well bottom plugged plate

DRILLERS REMARKS:


MISSISSIPPI DEPARTMENT OF NATURAL RESOURCES  
BUREAU OF LAND & WATER RESOURCES

JUL 12 1984

RECEIVED

If well telescopes please sketch and show depths.

GROUND LEVEL

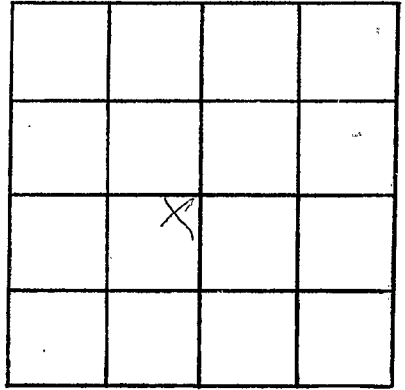

SECTION 5

Please indicate well location X.

ADDITIONAL INFORMATION

If more than one screen,  
show locations of each on sketch.