

**MISSISSIPPI DEPARTMENT OF NATURAL RESOURCES**  
**Bureau of Land and Water Resources**  
 Southport Mall  
 P.O. Box 10631  
 Jackson, Mississippi 39209  
**WATER WELL DRILLERS LOG**

**CODED**

<b>LEFLORE</b>
CL-3130
D63

**LEFLORE  
SUNFLOWER**

9-10 19 85      LAYNE-CENTRAL CO.      county well located


LANDOWNER:	description of formations encountered	from	to
EMMETT FINDLEY Brown Farm Schlater, MS (mailing address)			
<b>WELL LOCATION:</b> sec. 34 T 21 N R 1 E 2-1/2 miles E. Schlater (distance) (direction) of (nearest town)	fine sand	12	35
<b>WELL PURPOSE:</b> irrigation (home, irrigation, municipal, industrial)	coarse sand/gravel	35	98
<b>WELL COMPLETION DATA:</b>	rock	98	99
(1) diameter (inches) 32"	gravel	99	101
(2) total depth (feet) 114'	rock	101	103
(3) static water level (feet) 15 below above top of ground.	gravel	103	114
(4) casing steel 61' (material) (depth) 16" if telescope see back. (size)	rock	114	
(5) screen 50' 61' (length) (depth to top) 16" st. steel (size) (material)			
(6) pump 50" 2400 (HP) (yield gpm) electric (type power)			
(7) electric log no (yes or no)  (organization running log)			
(8) how well bottom plugged st. plate			

DRILLERS REMARKS:

NOV 13 1985  
 Department of Natural Resources  
 Bureau of Land & Water Resources

If well telescopes please sketch and show depths.

GROUND LEVEL

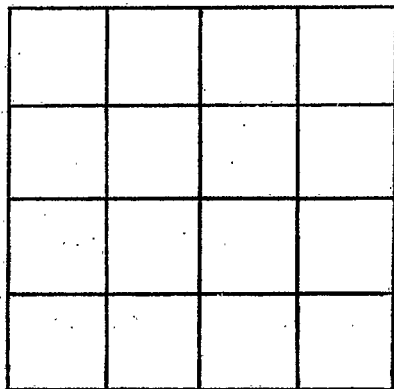

SECTION \_\_\_\_\_

Please indicate well location X.

ADDITIONAL INFORMATION

If more than one screen,  
show locations of each on sketch.