

MISSISSIPPI DEPARTMENT OF NATURAL RESOURCES

Bureau of Land and Water Resources

Southport Mall

P.O. Box 10631

CODED

BUTANE GAS CO. OF GREENWOOD, MISSISSIPPI 39209

POST OFFICE BOX 10631

GREENWOOD, MISS. 38850

Leflore
D/66
7-25-81

7-25 1981 date well completed Leflore firm name Leflore county well located

LANDOWNER:	description of formations encountered	from	to
<u>Nelso Plantation</u>	<u>Clay</u>	<u>0</u>	<u>20</u>
<u>Sunnyside Mo.</u> (mailing address)	<u>fine sand</u> <u>mixed sand & gravel</u>	<u>20</u> <u>60</u>	<u>60</u> <u>110</u>

WELL LOCATION:
sec 17 T 24 N R 1 E
1.5 miles S of Sunnyside
(distance) (direction) (nearest town)

WELL PURPOSE: irrigation
(home, irrigation, municipal, industrial)

- WELL COMPLETION DATA:
- (1) diameter (inches) 16"
 - (2) total depth (feet) 110
 - (3) static water level (feet) 25 (below/above top of ground)
 - (4) casing Steel, 70 (material), (depth)
 - 16" (size) if telescope see back.
 - (5) screen 40, 70 (length), (depth to top)
 - 16", steel (size), (material)
 - (6) pump 80, 1500 (HP), (yield gpm)
 - Diesel (type power)
 - (7) electric log _____ (yes or no)
 - _____ (organization running log)
 - (8) how well bottom plugged steel plate


CODED



DRILLERS REMARKS:

If well telescopes please sketch and show depths.

GROUND LEVEL

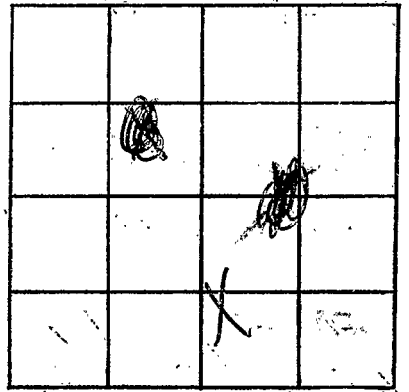

SECTION ~~12~~

Please indicate well location X.

ADDITIONAL INFORMATION

If more than one screen, show locations of each on sketch.