

MISSISSIPPI DEPARTMENT OF NATURAL RESOURCES

Bureau of Land and Water Resources

Southport Mall

P.O. Box 10631

Jackson, Mississippi 39209

CODED

Leflore
D167
7-27-81

BUTANE GAS OR WATER WELL DRILLERS LOG

POST OFFICE BOX 1135

GREENWOOD, MISS. 38930


7-27
date well completed

Leflore
firm name

Leflore
county well located

LANDOWNER:	description of formations encountered	from	to
<u>Nebos Plantation</u>	<u>Clay</u>	<u>0</u>	<u>16</u>
<u>Sunnyside, Ms</u>	<u>fine & sand</u>	<u>16</u>	<u>34</u>
(mailing address)	<u>sand & gravel</u>	<u>34</u>	<u>98</u>
	<u>Rock</u>	<u>98</u>	
WELL LOCATION:			
sec. <u>17</u> T <u>21</u> N R <u>1</u> E			
<u>1.5</u> miles <u>W</u> of <u>Sunnyside</u>			
(distance) (direction) (nearest town)			
WELL PURPOSE: <u>irrigation</u>			
(home, irrigation, municipal, industrial)			
WELL COMPLETION DATA:			
(1) diameter (inches) <u>16"</u>			
(2) total depth (feet) <u>98</u>			
(3) static water level (feet) <u>25</u> <small>(below above)</small>			
(4) casing <u>Steel</u> , <u>58</u>			
(material) (depth)			
<u>16"</u> if telescope see back.			
(size)			
(5) screen <u>40</u> , <u>58</u>			
(length) (depth to top)			
<u>16"</u> , <u>steel</u>			
(size) (material)			
(6) pump <u>60</u> , <u>1000</u>			
(HP) (yield gpm)			
<u>Direct</u>			
(type power)			
(7) electric log <u> </u>			
(yes or no)			
(organization running log)			
(8) how well bottom plugged			
<u>Steel plate</u>			

CODED

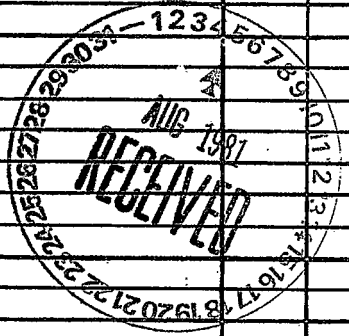

DRILLERS REMARKS:

If well telescopes please sketch and show depths.

GROUND LEVEL

	X		

SECTION 17

Please indicate well location X.

ADDITIONAL INFORMATION

If more than one screen,
show locations of each on sketch.