

MISSISSIPPI DEPARTMENT OF NATURAL RESOURCES

Bureau of Land and Water Resources

Southport Mall

P.O. Box 10631

Jackson, Mississippi 39209 **CODED**

*Leflore*  
*D 168*  
*7-29-81*

**BUTANE GAS WATER WELLED DRILLERS LOG**

POST OFFICE BOX 1135

GREENWOOD, MISS. 39320

*Leflore*  
county well located

*7-29*  
date well completed

firm name

LANDOWNER:

*Neco Plantation*  
*Summerside, Ms.*  
(mailing address)

description of formations encountered

description of formations encountered	from	to
<i>Fine sand</i>	<i>0</i>	<i>28</i>
<i>sand</i>	<i>28</i>	<i>50</i>
<i>Sand + p. gravel</i>	<i>50</i>	<i>100</i>
<i>Rock</i>	<i>100</i>	

WELL LOCATION:

sec. *17* T *40* R *1* E  
S W  
miles *1* SW of *Summerside*  
(distance) (direction) (nearest town)

WELL PURPOSE: *Irrigation*  
(home, irrigation, municipal, industrial)

WELL COMPLETION DATA:

- (1) diameter (inches) *16"*
- (2) total depth (feet) *100*
- (3) static water level (feet) *25* <sup>below</sup>/<sub>above</sub> top of ground.
- (4) casing *Steel*, *60*  
(material) (depth)  
*16"* if telescope see back.  
(size)
- (5) screen *40'*, *60*  
(length) (depth to top)  
*16"*, *Steel*  
(size) (material)
- (6) pump *60*, *1000*  
(HP) (yield gpm)  
*Direct*  
(type power)
- (7) electric log \_\_\_\_\_  
(yes or no)  
(organization running log)

**CODED**




(8) how well bottom plugged  
*Steel plate*

DRILLERS REMARKS:

If well telescopes please sketch and show depths.

GROUND LEVEL

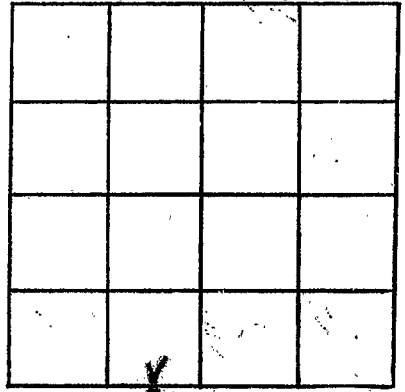

SECTION 17

Please indicate well location X.

ADDITIONAL INFORMATION

If more than one screen, show locations of each on sketch.