

MISSISSIPPI DEPARTMENT OF NATURAL RESOURCES

Bureau of Land and Water Resources

Southport Mall

P.O. Box 10631

Jackson, Mississippi 39209

CODED

BUTANE GAS WATER WELL DRILLERS LOG

POST OFFICE BOX 1135

19 81 GREENWOOD, MISS. 39230

Leflore  
D169  
7-30-81

7-30  
date well completed

Leflore  
firm name

Leflore  
county well located


LANDOWNER:	description of formations encountered	from	to
<u>Nebo Plantation</u>	<u>hard clay</u>	<u>0</u>	<u>20</u>
<u>Sunnyside Ms.</u>	<u>fine sand</u>	<u>20</u>	<u>52</u>
(mailing address)	<u>tree</u>	<u>52</u>	<u>59</u>
WELL LOCATION:	<u>sand + pea gravel</u>	<u>59</u>	<u>64</u>
sec. <u>18</u> T <u>24</u> N R <u>1</u> E	<u>sand + gravel</u>	<u>64</u>	<u>100</u>
1.75 miles S.W. of <u>Sumner</u>			
(distance) (direction) of (nearest town)			
WELL PURPOSE: <u>irrigation</u> (home, irrigation, municipal, industrial)			
WELL COMPLETION DATA:			
(1) diameter (inches) <u>16"</u>			
(2) total depth (feet) <u>100</u>			
(3) static water level (feet) <u>30</u> <sup>below</sup> <sub>above</sub> top of ground.			
(4) casing <u>Steel</u> , <u>60'</u> (material) (depth)			
<u>16"</u> (size) If telescope see back.			
(5) screen <u>40'</u> <u>60'</u> (length) (depth to top)			
<u>16"</u> , <u>steel</u> (size) (material)			
(6) pump <u>80</u> <u>1500</u> (HP) (yield gpm)			
<u>Acurl</u> (type power)			
(7) electric log _____ (yes or no)			
_____ (organization running log)			
(8) how well bottom plugged <u>steel plate</u>			
DRILLERS REMARKS:			

CODED



If well telescopes please sketch and show depths.

GROUND LEVEL

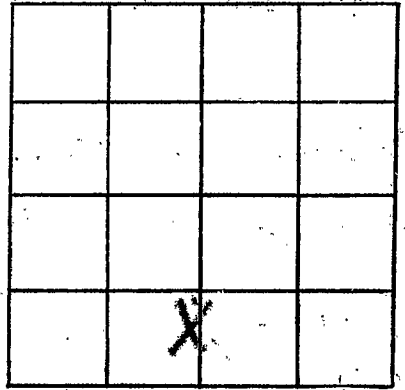

SECTION 11

Please indicate well location X.

ADDITIONAL INFORMATION

If more than one screen,  
show locations of each on sketch.