

MISSISSIPPI DEPARTMENT OF NATURAL RESOURCES

Bureau of Land and Water Resources

Southport Mall

P.O. Box 10631

Jackson, Mississippi 39209

CODED

WATER WELL DRILLERS LOG

Leflore
D170
7-31-81

Burtam Gas Co.
of Greenwood, Mo.

Leflore

7-31 1981
date well completed

firm name

county well located

LANDOWNER:

Conway Farms

Sunnyside, Mo.
(mailing address)

WELL LOCATION:

sec. 8 T. 24 N. R. 1 E. W. W
1.5 miles NW of Sunnyside
(distance) (direction) (nearest town)

WELL PURPOSE: Irrigation
(home, irrigation, municipal, industrial)

WELL COMPLETION DATA:

- (1) diameter (inches) 16"
- (2) total depth (feet) 100
- (3) static water level (feet) 30 (below/above top of ground)
- (4) casing Steel, 60 (material), (depth)
16" (size) if telescope see back.
- (5) screen 40', 60 (length), (depth to top)
16" (size), steel (material)
- (6) pump 60 (HP), 1000 (yield gpm)
Diesel (type power)
- (7) electric log _____ (yes or no)

(organization running log)

(8) how well bottom plugged Steel plate

DRILLERS REMARKS:


description of formations encountered

from

to


<u>hard sand</u>	<u>0</u>	<u>10</u>
<u>fine sand</u>	<u>10</u>	<u>40</u>
<u>sand</u>	<u>40</u>	<u>50</u>
<u>good sand</u>	<u>50</u>	<u>55</u>
<u>sea gravel</u>	<u>55</u>	<u>60</u>
<u>sand & gravel</u>	<u>60</u>	<u>100</u>
<u>rock</u>	<u>100</u>	

CODED

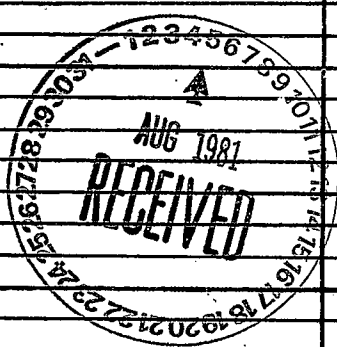

If well telescopes please sketch and show depths.

GROUND LEVEL

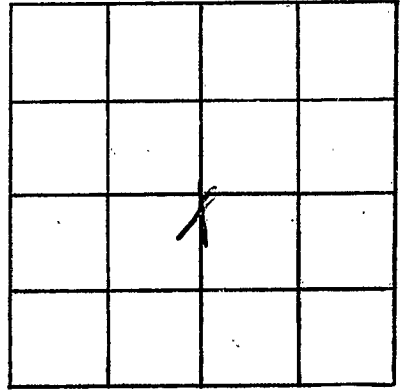

SECTION 8

Please indicate well location X.

ADDITIONAL INFORMATION

If more than one screen, show locations of each on sketch.