

MISSISSIPPI DEPARTMENT OF NATURAL RESOURCES

Bureau of Land and Water Resources

Southport Mall

P.O. Box 10631

Jackson, Mississippi 39209

WATER WELL DRILLERS LOG

CODED

LEFLORE
D171

86-239 DCP-01

9-9
date well completed

86 Open Well Inc
firm name

Leflore
county well located

LANDOWNER: Wayne Brisk

Rt. 7, Box E-74
Schlater, MS. 38952
(mailing address)

description of formations encountered	from	to
Top Soil + ch.	0	40
fine sand	41	54
Course Sand	55	80
Course Sand + gravel	81	115

WELL LOCATION:

sec. 12 T 21 N S R 1 E W
miles of Money
(distance) (direction) (nearest town)

WELL PURPOSE: Irrigation
(home, irrigation, municipal, industrial)

CODED

WELL COMPLETION DATA:

- (1) diameter (inches) 16"
- (2) total depth (feet) 115
- (3) static water level (feet) _____ below above top of ground.
- (4) casing Steel, 75, (material) (depth)
16 (size) If telescope see back.
- (5) screen 40 (length) (depth to top)
16 (size) Mild steel (material)
- (6) pump 70 (HP) 2500 (yield gpm)
Diesel (type power)
- (7) electric log no (yes or no)
- (organization running log)

RECEIVED

MAR 30 1997

Department of Natural Resources
Bureau of Land & Water Resources


(8) how well bottom plugged Plate

DRILLERS REMARKS:

86-239 DCP-01

If well telescopes please
sketch and show depths.

GROUND LEVEL

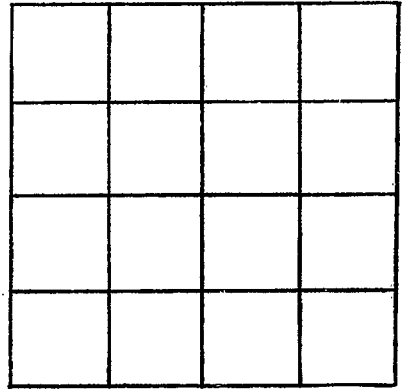

SECTION _____

Please indicate well location X.

ADDITIONAL INFORMATION

If more than one screen,
show locations of each on sketch.