

MISSISSIPPI DEPARTMENT OF NATURAL RESOURCES

Bureau of Land and Water Resources

Southport Mall

P.O. Box 10631

CODED

Jackson, Mississippi 39209

WATER WELL DRILLERS LOG

LEFLORE
D173

1987 BUTANE GAS CO. OF GREENWOOD

5-20 date well completed

firm name

LEFLORE county well located

LANDOWNER:	description of formations encountered	from	to
RACK RENT PLANTATION MASTERS CITY, MS. (mailing address)			
WELL LOCATION: sec. 11 T 21 N R 1 E 4 1/4 miles N/W of Moseley (distance) (direction) (nearest town)			
WELL PURPOSE: IRRIGATION (home, irrigation, municipal, industrial)			
WELL COMPLETION DATA:			
(1) diameter (inches) 10			
(2) total depth (feet) 100			
(3) static water level (feet) 20 below top of ground.			
(4) casing STEEL, 60 (material), (depth), 10" (size) if telescope see back.			
(5) screen 40 (length), 60 (depth to top), 10" (size), STEEL (material)			
(6) pump 15 (HP), 800 (yield gpm), FUEL (type power)			
(7) electric log NO (yes or no)			
(organization running log)			
(8) how well bottom plugged STEEL PLATE			
DRILLERS REMARKS:			

CODED


RECEIVED

JUN 03 1987

Department of Natural Resources
Bureau of Land & Water Resources

If well telescopes please sketch and show depths.

GROUND LEVEL

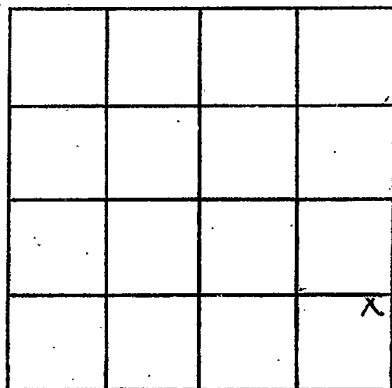

SECTION _____

Please indicate well location X.

ADDITIONAL INFORMATION

If more than one screen, show locations of each on sketch.