

MISSISSIPPI DEPARTMENT OF NATURAL RESOURCES

Bureau of Land and Water Resources

Southport Mall

P.O. Box 10631

Jackson, Mississippi 39209

WATER WELL DRILLERS LOG

Letmore  
D 174  
128 B

Coded

May 28 1987  
 date well completed

Dyer Well  
 firm name

Letmore  
 county well located

LANDOWNER	description of formations encountered	from	to
<u>Kathleen Jones</u>			
<u>Rt 1 Box 15</u>			
<u>Schlater Ms 38952</u> (mailing address)	<u>CLAY</u>	<u>0</u>	<u>40</u>
	<u>Fine Sand</u>	<u>40</u>	<u>48</u>
	<u>sand &amp; gravel</u>	<u>48</u>	<u>68</u>
	<u>Fine sand</u>	<u>68</u>	<u>80</u>
	<u>Sand &amp; Gravel</u>	<u>80</u>	<u>110</u>
<b>WELL LOCATION:</b> sec. <u>30</u> T <u>21</u> N R <u>1</u> E <u>1</u> miles <u>N</u> of <u>Schlater</u> (distance) (direction) (nearest town)			
<b>WELL PURPOSE:</b> <u>Irrigation</u> (home, irrigation, municipal, industrial)			
<b>WELL COMPLETION DATA:</b>			
(1) diameter (inches)	<u>16"</u>		
(2) total depth (feet)	<u>110'</u>		
(3) static water level (feet)		below	above
top of ground			
(4) casing	<u>steel</u>		
(material)	(depth)		
<u>16"</u>			
(size)	if telescope see back.		
(5) screen	<u>40'</u>		
(length)	(depth to top)		
<u>16"</u>			
(size)	(material)		
(6) pump	<u>30</u>	<u>1500</u>	
(HP)	(yield gpm)		
(type power)			
(7) electric log	<u>No</u>		
(yes or no)			
(organization running log)	<u>None</u>		
(8) how well bottom plugged	<u>Plate</u>		

RECEIVED


OCT 30 1987

Department of Natural Resources  
 Bureau of Land & Water Resources

DRILLERS REMARKS:

If well telescopes please  
sketch and show depths.

GROUND LEVEL

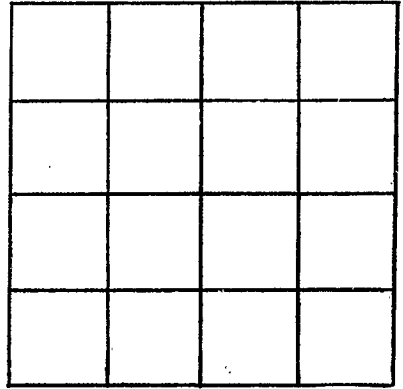

SECTION \_\_\_\_\_

Please indicate well location X.

ADDITIONAL INFORMATION

If more than one screen,  
show locations of each on sketch.