

MISSISSIPPI DEPARTMENT OF NATURAL RESOURCES

Bureau of Land and Water Resources

Southport Mall

P.O. Box 10631

Jackson, Mississippi 39209

WATER WELL DRILLERS LOG

LEFLORE
D175
CODED

7-25

1988 BUTANE GAS CO. OF GREENWOOD

LeFlore

date well completed

firm name

county well located

LANDOWNER:	description of formations encountered	from	to
F. G. Kelly 923 Longview Drive SUGAR LAND, TEXAS (mailing address)	CLAY	0	18
	SAND	18	75
	GRAVEL	75	125
WELL LOCATION: sec. 11 T. 21 N. R. 1 E 2 miles W of Ruby (distance) (direction) (nearest town)	CLAY	125	145
	SAND + CLAY	145	255
	CLAY	255	312
	ROCK	312	315
	SAND	315	350
WELL PURPOSE: Home (home, irrigation, municipal, industrial)	SANDY SHALE	350	655
	SHALE + SAND	655	915
WELL COMPLETION DATA:	SAND	715	770
	SAND + SHALE	770	803
(1) diameter (inches) 4 X ✓			
(2) total depth (feet) 756			
(3) static water level (feet) 6 below top of ground.			
(4) casing Steel, 736 (material), (depth) 4 X ✓ if telescope see back. (size)			
(5) screen 20, 736 (length), (depth to top) 2, Strainless Steel (size), (material)			
(6) pump 1, 18 (HP), (yield gpm) Elec (type power)			
(7) electric log NO (yes or no)			
(organization running log)			
(8) how well bottom plugged Back Pressure Valve			
DRILLERS REMARKS:			


If well telescopes please sketch and show depths.

GROUND LEVEL

105' - 4" Casing →

630' - 2" Casing →

20' - 2" Screen →

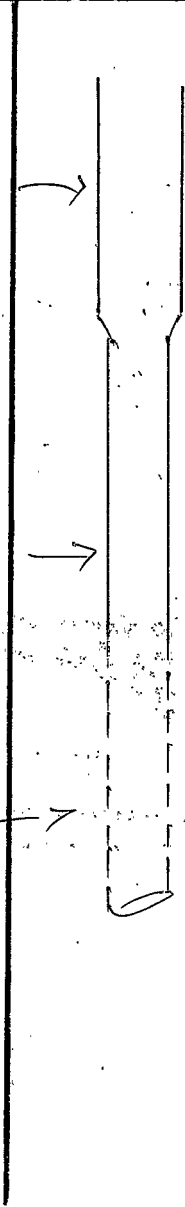

SECTION 11

Please indicate well location X.

ADDITIONAL INFORMATION

If more than one screen, show locations of each on sketch.