

MISSISSIPPI DEPARTMENT OF NATURAL RESOURCES

Bureau of Land and Water Resources

Southport Mall

P.O. Box 10631

Jackson, Mississippi 39209

CODED

WATER WELL DRILLERS LOG

BUTANE GAS COMPANY

OF GREENWOOD

Leflore

~~E-102~~
LEFLORE
8-10-83

D186

8-10

1983

date well completed

county well located

LANDOWNER:	description of formations encountered	from	to
<i>Brown Farms</i>			
<i>Schlater Mo.</i>	<i>Clay</i>	<i>20</i>	<i>55</i>
(mailing address)	<i>Sand & gravel</i>	<i>55</i>	<i>100</i>
WELL LOCATION:			
sec. 32 <i>21N</i> R. <i>1E</i>			
<i>1</i> miles <i>NE</i> of <i>S</i>			
(distance) (direction) (nearest town)			
WELL PURPOSE:			
(home, irrigation, municipal, industrial)			
WELL COMPLETION DATA:			
(1) diameter (inches) <i>16"</i>			
(2) total depth (feet) <i>100'</i>			
(3) static water level (feet) <i>34</i> ^{below} above top of ground.			
(4) casing <i>Steel</i> , <i>60'</i>			
(material) (depth)			
<i>16"</i> if telescope see back.			
(size)			
(5) screen <i>40</i> , <i>60'</i>			
(length) (depth to top)			
<i>16"</i> , <i>Steel</i>			
(size) (material)			
(6) pump <i>40</i> , <i>2000</i>			
(HP) (yield gpm)			
<i>Diesel</i>			
(type power)			
(7) electric log <i>No</i>			
(yes or no)			
<i>No</i>			
(organization running log)			
(8) how well bottom plugged <i>Steel plate</i>			
DRILLERS REMARKS:			
<i>Carla Ramos</i>			

CODED


DEPT. OF NATURAL RESOURCES
BUREAU OF LAND & WATER RESOURCES

AUG 12 1983

RECEIVED

If well telescopes please sketch and show depths.

GROUND LEVEL

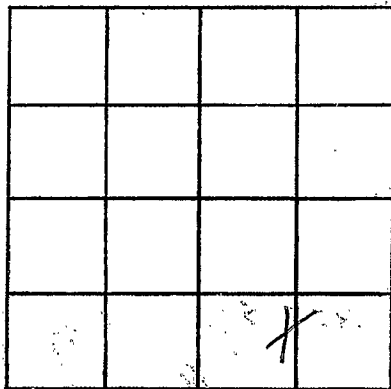

SECTION 82

Please indicate well location X.

ADDITIONAL INFORMATION

If more than one screen, show locations of each on sketch.