State W	Vell Report			
i	Part 1 For Office Use Only:			
Mississippi Donortmon	at of Environmental Quality Aquifer:			
Permit # (O (U 4/545) Office of Lands	and Water Resources Well #: D- 189			
Druier:	50X 10051			
	MS 39289-0631 L. S. Elevation:			
	961-5210 4-6938 (fax) E-log #:			
(001)33	4-0938 (lax) E-log #:			
State Law requires that this report be prepared by the 30 days of completion of drilling of the well.	driller in detail and filed with the Department within			
Well Owner Information	Well Location			
Owner Name Brown Farms	33 38 28.8 90 18 47.4W Latitude: Longitude: Variable Longitude: L			
	29 47			
Mailing Address: BOX 9	Method of Lat/Long (circle one): Conventional Survey,			
	USGS quad, Hand-held GPS, Survey-grade GPS			
	NE 1/4 SE 1/4 Sec 32 Twn 21N Rng 1W			
Schlater MS 38952				
City State Zip Code	Distance Direction Nearest Town			
Telephone No. ()	1 Miles <u>Fast</u> of <u>Schlater</u>			
	· · · · · · · · · · · · · · · · · · ·			
Well I	Data			
Purpose of Well (circle one) Home Industrial Public Supply	Irrigation Fish Culture Other:			
Date well drilling started: 2-24-07 Date w	well drilling completed: 2-24-07			
If flowing, method of flow regulation: Valve Other (d	escribe)			
Static Water Level: 19' feet above or sclow (circle one) l	and surface Date measured: 2-26-07			
Method of Measurement (circle one) steel tape electric tape air line other:				
Hole depth:116	Well grouted to a depth offeet			
Type of grout (circle one): Cement Bentonne Mix				
Casing length: 76 feet Casing diameter. 10	inches Type of casing: PVC160			
Screen length: 40 feet Screen diameter: 10	inches Type of screen: PVC160			

I certify that the well was drilled, constructed, and completed in accordance with all applicable requirements of the Mississippi

Setting depth: From _____77

Department of Environmental Quality and/or the Mississippi Department of Health regulations and state Jaws.

Other (describe): ___

Logs run (circle all applicable): No log run Electric Gamma Ray Density Sonic Neutron Other:

Irrigation Equipment Inc. Patrick M. Chism 0695

Print Name of Water Well Contractor and License No.

Screen slot size: . 050

Type of completion (circle all applicable):

Top of lap pipe or reduction in casing:

Name of organization running log(s):

Signature of Water Well Contractor

feet

feet to 116

feet. If telescoped or more than one screen, describe on back of page

Gravel packed Underreamed Telescoped Open hole Natural Development

RECEIVED


MAR 1 2 2007

Ground Level

Description of Formations Encountered	From	То
	0	20
Clay Fine Sand	21	35
Fine Sand/grayel	36	53
Fine Sand/gravel Med. Sand/gravel	54	116
Julia		\perp
		<u> </u>
		oxdot
	<u> </u>	$oxed{oxed}$
		J
		1
		\perp

If more than one screen, show location of each on sketch

Sketch the property layout and include the following: 1) the well location; 2) any permanent structures on the property that may aid in locating the well; 3) any roads, power lines, or other items that may aid in locating the property and the well; 4) indicate direction.

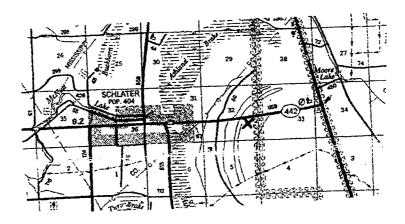

Landowner Name:		

Signature of Water Well Contractor

STATE WELL REPORT Part 2

County: Leflore

Permit#: 6 W 41543

Irrigation Equipment
Date completed: 2-24-07

Pump Installer's Completion Report
Mississippi Department of Environmental Quality
Office of Land and Water Resources
P.O. Box 10631
Jackson, MS 39289-0631
(601)361-5210
(601)354-6938 (for)

For Office Use Only:		
Aquifer:		
Well#: D- 189		
Elevation:		

	(001)	534-0938 (IRK)	
ould be prepared b pump.	y the pump installer in de	tail and filed with the Depa	ertment within 30 days of the
Well Owner Infor	mation		Well Location
Brown Farm	ns	Latitude:	Longitude:
Box 9		Method of Lat/Long (circ	cle one): Conventional Survey,
		USGS quad,	Hand-held GPS, Survey-grade GPS
		NE 1/4 SE 1/4 Sec	32 Twn 21N Rng 1W
City Sta	te Zip Code	Distance Direction	on Nearest Town
)		1 Miles East	of Schlater
Pum p Type Circle one			Power Type Circle one
Jet	Submersible	Diesel Engine Ga	asoline Engine Natural Gas
Piston	Turbine	Electric Motor H	and Tractor PTO
Rotary	Flowing Well	Windmill O	ther (specify):
		Horse Power Rating of M	lotor: 30
2-26-07	7	Setting Depth: 7	0 feet
y: 1150	Gallons Per Minute	Number of Stages:	
Pump Test Da	ıta	Method o	f Measuring Water Level Circle one
A):F	eet Below Land Surface	Air Line Electric	Measuring Line Steel Tape
el (B):F	eet Below Land Surface	Other (specify):	
\)]:F	eet Below Land Surface	For flowing well, measure	ed shut in head:feet
	Gallons Per Minute	Well yielded	GPM with a drawdown of
est (minimum 4 hou	rs):hours	feet afi	terhours of pumping
	Well Owner Infor	ould be prepared by the pump installer in depump. Well Owner Information Brown Farms Box 9 Schlater MS 38952 Sity State Zip Code Pump Type Circle one Jet Submersible Piston Turbine	Well Owner Information Brown Farms Box 9 Method of Lat/Long (circle one Stages:

I HEREBY CERTIFY that the above statements are true to the best	of my knowledge	
Patrick M. Chism 0695	Vatu M Ch	
Print Name of Pump Installer and License No. (if applicable)	Signature of Pump Installer	

FIECEIVED