

MISSISSIPPI DEPARTMENT OF NATURAL RESOURCES

Bureau of Land and Water Resources

Southport Mall

P.O. Box 10631

Jackson, Mississippi 39209

CODED

BUTANE GAS COMPANY
WATER WELL DRILLERS LOG

OF GREENWOOD

Leflore

~~E-77~~
LEFLORE
8-12-83
D 204

D-
CW 744

8-12-1983
date well completed

firm name

county well located

LANDOWNER:

description of formations encountered

from

to

Brown Farms

Clay

0

15

Schlater, Ma
(mailing address)

Sand

15

45

Sand + gravel

45

105

WELL LOCATION:

sec. 32 T 21 N R 1 E
S 1 W
1 miles E of Schlater
(distance) (direction) (nearest town)

WELL PURPOSE:

(home, irrigation, municipal, industrial)

WELL COMPLETION DATA:

CODED

- (1) diameter (inches) 16"
- (2) total depth (feet) 705
- (3) static water level (feet) 30 ^{below} _{above} top of ground.
- (4) casing Steel, 65
(material) (depth)
16" if telescope see back.
(size)
- (5) screen 40, 65
(length) (depth to top)
16", Steel
(size) (material)
- (6) pump 60, 2000
(HP) (yield gpm)
Elect
(type power)
- (7) electric log No
(yes or no)
No
(organization running log)
- (8) how well bottom plugged Steel plate

DEPT. OF NATURAL RESOURCES
BUREAU OF LAND & WATER RESOURCES

SEP 15 1983


RECEIVED

DRILLERS REMARKS:

Carlo Ramos

If well telescopes please sketch and show depths.

GROUND LEVEL

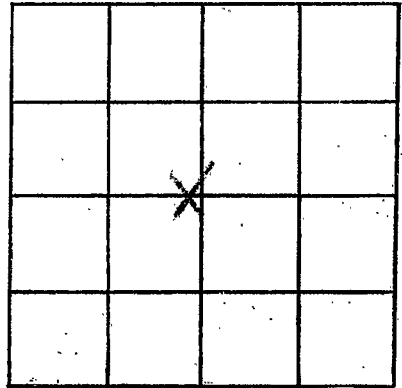

SECTION E2

Please indicate well location X.

ADDITIONAL INFORMATION

If more than one screen, show locations of each on sketch.