

MISSISSIPPI BOARD OF WATER COMMISSIONERS

D-1001

WATER WELL DRILLERS LOG

Date: 2/18, 1963, Driller: Delta Well Supply Co. County Leflore

(Name)

F

(1) Owner of Land: Wabi Plantation
(Name)
RFD 1 Schlater
(Address)

(2) Location: 1/4, 1/4, Sec. T R
5 miles east, of Blaine
(distance) (direction) (Nearest Town)

(3) Topography: (Hilly) (Flat) (Level)

(4) Purpose of Well: Irrigation
(Domestic Irrigation Municipal Industrial, Other)

Description & Color of Materials Sand, Clay, Red Clay, Shell, etc.	Thick- ness Feet	Depth Feet
<u>sand clay</u>	<u>21</u>	
<u>Blue sand clay</u>	<u>36</u>	<u>57</u>
<u>Fine sand</u>	<u>11</u>	<u>68</u>
<u>Sand & Gravel</u>	<u>22</u>	<u>90</u>
<u>Fine sand</u>	<u>12</u>	<u>102</u>
<u>Sand rock</u>	<u>6"</u>	<u>102 1/2</u>
<u>Course sand & gravel</u>	<u>3 1/2</u>	<u>105</u>
<u>Red clay</u>		

Information upon completion of well:

(1) Diameter 16 inches.

(2) Total Depth 105 feet.

(3) Water Level 18 feet below top of ground.

(4) Cased to , Size .


(5) Screen: Size 16, Length 40.

(6) Were any formations sealed against pollution?
 yes, no.

If YES depth of formation .

Why .

Drillers Remarks:

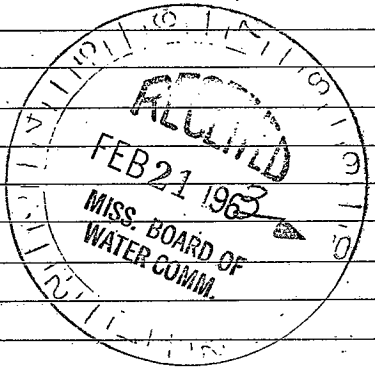

(Use Back Side)

Well No.

