

Date: SEPT. 23, 1961, Driller: DELTA DRILLING CO. County LEFLORE
 (Name)


(1) Owner of Land: <u>W. R. BOND</u> (Name)	Description & Color of Materials Sand, Clay, Red Clay, Shell, etc.	Thick- ness Feet	Depth Feet
(2) Location: <u>SW 1/4, SW 1/4, Sec. 22 T21R1E</u>	<u>GUMBO</u>	<u>42</u>	<u>42</u>
<u>2</u> miles <u>EAST</u> of <u>MONEY</u> (distance) (direction) (Nearest Town)	<u>SAND</u>	<u>64</u>	<u>106</u>
(3) Topography: _____ (Hilly) (Flat) (Level)	<u>GRAVEL</u>	<u>44</u>	<u>150</u>
(4) Purpose of Well: <u>DOMESTIC</u> (Domestic Irrigation Municipal, Industrial, Other)	<u>GUMBO W/5" ROCK</u>	<u>81</u>	<u>231</u>
	<u>GREEN SAND</u>	<u>83</u>	<u>314</u>
	<u>SHALE</u>	<u>104</u>	<u>418</u>
	<u>GUMBO</u>	<u>22</u>	<u>440</u>
	<u>SHALE CODED</u>	<u>123</u>	<u>563</u>
	<u>GUMBO</u>	<u>19</u>	<u>582</u>
	<u>SAND W/SHALE STREAKS</u>	<u>61</u>	<u>643</u>
	<u>GUMBO</u>	<u>11</u>	<u>654</u>
	<u>SAND</u>	<u>32</u>	<u>686</u>
	<u>SHALE</u>	<u>10</u>	<u>696</u>

Information upon completion of well:

- (1) Diameter 3 inches.
- (2) Total Depth 696 feet.
- (3) Water Level WELL FLOWS feet below top of ground.
- (4) Cased to 696', Size 3"-392', 2"-304'
- (5) Screen: Size 2", Length 20'
- (6) Were any formations sealed against pollution?
 _____ yes, _____ no.

If YES depth of formation _____
 Why _____

Drillers Remarks: 20' LAP OF 2" IN 3" PIPE
10' 2" TAIL PIPE ON BOTTOM OF WELL
WELL FLOWS 86 GPM -
PRESSURE 12#

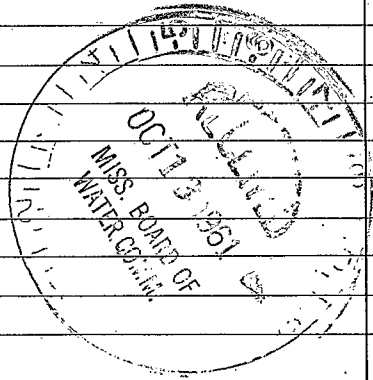

(Use Back Side)

Well No.

