

LeFlore
E 5
2-63

WATER WELL DRILLERS LOG

CODED

Date: FEB, 1963, Driller: DELTA DRILLING Co. County LEFLORE
(Name)

- (1) Owner of Land: J. H. EVERETTE
(Name)
MONEY, MISS.
(Address)
- (2) Location: NW 1/4, NE 1/4, Sec. 26 T24N R1E
_____ miles _____, of _____
(distance) (direction) (Nearest Town)
- (3) Topography: _____
(Hilly) (Flat) (Level)
- (4) Purpose of Well: DOMESTIC
(Domestic Irrigation
Municipal, Industrial, Other)


Description & Color of Materials Sand, Clay, Red Clay, Shell, etc.	Thick-ness Feet	Depth Feet
GUMBO	19	19
SAND	50	69
GRAVEL	73	142
GUMBO W/ROCKS	85	227
SHALE W/ROCK	52	279
SAND	172	296
SHALE W/ROCK	14	310
SAND W/ROCK	40	350
SHALE	12	362
SAND W/ROCK	40	402
SHALE	30	432
GUMBO	13	445
SAND	20	465
SHALE	65	530
SAND	10	540
GUMBO	8	548
SHALE	25	573
SAND	35	608
SHALE	13	620
SAND	24	644

Information upon completion of well:

- (1) Diameter 3 inches.
- (2) Total Depth 644 feet.
- (3) Water Level WELL FLOWS feet below top of ground.
- (4) Cased to 624, Size 3" - 350, 2" - 296
- (5) Screen: Size 2", Length 20'
- (6) Were any formations sealed against pollution?
_____ yes, _____ no.

If YES depth of formation _____
Why _____

Drillers Remarks: 22' LAP OF 2"
IN 3" PIPE -

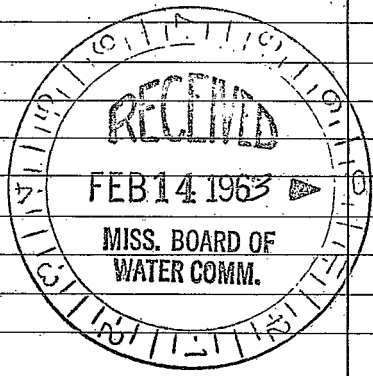

(Use Back Side)

Well No.

