

LEFLORE
E7
1-12-71

MISSISSIPPI
 BOARD OF WATER COMMISSIONERS
 416 North State Street
 Jackson, Mississippi 39201

CODED

WATER WELL DRILLERS LOG
 BUTANE GAS CO. OF GREENWOOD

1-12-71 19 71 POST OFFICE BOX 1135 Leflore
 date well completed GREENWOOD, MISS. 38930 county well located

LANDOWNER:
O.F. Bledsoe Plantation
Greenwood, Miss.
 (mailing address)

description of formations encountered	from	to
<u>Clay</u>	<u>0</u>	<u>18</u>
<u>SAND</u>	<u>18</u>	<u>60</u>
<u>SAND + GRAVEL</u>	<u>60</u>	<u>83</u>

WELL LOCATION:
 sec. 29 T. 2 N. R. 1 E
1 miles West of Money
 (distance) (direction) (nearest town)

WELL PURPOSE: Home
 (home, irrigation, municipal, industrial)

WELL COMPLETION DATA:

(1) diameter (inches) 2"

(2) total depth (feet) 83

(3) static water level (feet) 18 below top of ground.

(4) casing Steel, 73,
 (material) (depth)
2" if telescope see back.
 (size)

(5) screen 10', 73
 (length) (depth to top)
2" PVC
 (size) (material)

(6) pump 1/3, 8
 (HP) (yield gpm)
Elec.
 (type power)

(7) electric log No
 (yes or no)

(organization running log)

(8) how well bottom plugged Lead Plug

CODED


FEB 11 1971

DRILLERS REMARKS:
OK

MISS. BOARD OF WATER COMMISSIONERS

If well telescopes please sketch and show depths.

GROUND LEVEL

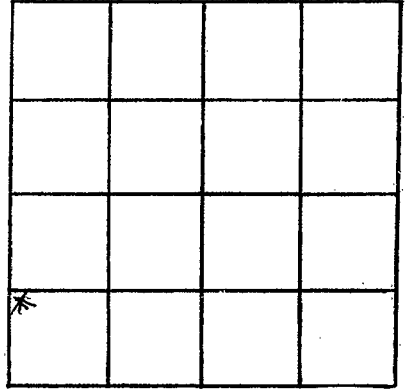

SECTION 29

Please indicate well location X.

ADDITIONAL INFORMATION

If more than one screen,
show locations of each on sketch.