

LEFLORE

E 8

4-6-71

MISSISSIPPI
 BOARD OF WATER COMMISSIONERS
 416 North State Street
 Jackson, Mississippi 39201

CODED

WATER WELL DRILLERS LOG

BUTANE GAS CO. OF GREENWOOD
 POST OFFICE BOX 1135
 GREENWOOD, MISS. 38930

APRIL 6, 1971

date well completed

GREENWOOD firm name

Leflore

county well located

LANDOWNER:

C. P. Elliot

Money, Miss.
 (mailing address)

WELL LOCATION:

sec. 20 T 21 N R 1 E
 S W
 1 miles N of Money
 (distance) (direction) (nearest town)

WELL PURPOSE: Home
 (home, irrigation, municipal, industrial)

WELL COMPLETION DATA:

- (1) diameter (inches) 2"
- (2) total depth (feet) 640
- (3) static water level (feet) 12 above
 top of ground. below
- (4) casing Steel, 630
 (material) (depth)
2"
 (size) If telescope see back.
- (5) screen 10', 630
 (length) (depth to top)
2", Stainless Steel
 (size) (material)
- (6) pump 1/2, 10
 (HP) (yield gpm)
Elec
 (type power)
- (7) electric log no
 (yes or no)

(organization running log)

(8) how well bottom plugged/
Back wash valve

DRILLERS REMARKS:

description of formations encountered

from

to

Clay	0	30
SAND + Pea Gravel	30	110
Clay	110	125
White Sand	125	202
HARD SHALE	202	246
SHALE SAND ROCK	246	606
HARD PACKED SAND	606	654


CODED

APR - 9 1971

MISS. BD. OF WATER COMM

If well telescopes please sketch and show depths.

GROUND LEVEL

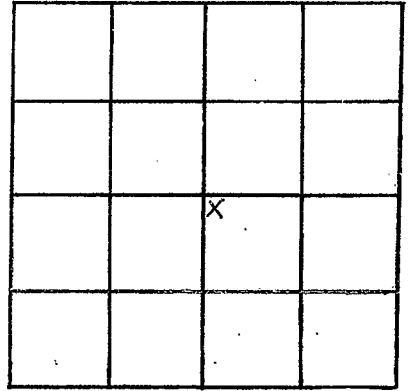

SECTION 20

Please indicate well location X.

ADDITIONAL INFORMATION

If more than one screen,
show locations of each on sketch.