

MISSISSIPPI
BOARD OF WATER COMMISSIONERS
416 North State Street
Jackson, Mississippi 39201

CODED

WATER WELL DRILLERS LOG

LEFLORE
E 10
12-22-73

12-22 1972 **DYER WELL & IRRIGATION SERVICE** **LEFLORE**
date well completed firm name county well located

LANDOWNER: **Mrs. D.C. OAKES**
MONEY
Miss.
(mailing address)

WELL LOCATION:
sec. **22** T. **21** N. R. **1** E
1 1/2 miles **N.E.** of **MONEY**
(distance) (direction) (nearest town)

WELL PURPOSE: **Home**
(home, irrigation, municipal, industrial)

- WELL COMPLETION DATA:
- (1) diameter (inches) **4" x 2"**
 - (2) total depth (feet) **382'**
 - (3) static water level (feet) **From** ^{below} _{above} top of ground.
 - (4) casing **BUXID**, **362'**
(material) (depth)
12" x 4" **236'-2"**
(size) if telescope see back.
 - (5) screen **20'**, **362'**
(length) (depth to top)
2" **STAINLESS STEEL**
(size) (material)
 - (6) pump **3/4** **15**
(HP) (yield gpm)
ELEC
(type power)
 - (7) electric log **No**
(yes or no)
 - (8) how well bottom plugged **B.P.U.**

description of formations encountered	from	to
Clay	0	18
Sand	18	78
Sand & gravel	78	122
Clay	122	138
Sand	138	142
Gummy Clay	142	182
Sand & Shale	182	217
Shale & Rock st.	217	237
Shale & Sand st.	237	362
Sand & Shale st.	362	382

CODED


DRILLERS REMARKS:

JUN 27 1973

If well telescopes please sketch and show depths.

GROUND LEVEL

4" DIRECT COMPLETION
WITH SAND SCREEN

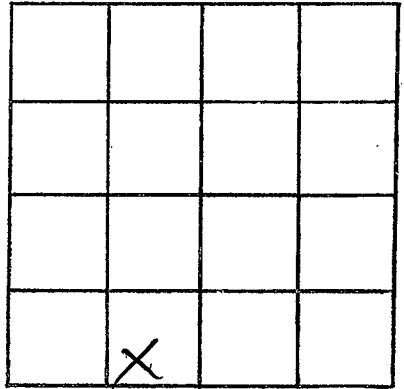

SECTION 22

Please indicate well location X.

ADDITIONAL INFORMATION

If more than one screen,
show locations of each on sketch.