

LEFLORE  
E 12  
12-10-74

MISSISSIPPI  
BOARD OF WATER COMMISSIONERS  
416 North State Street  
Jackson, Mississippi 39201

CODED

WATER WELL DRILLERS LOG

12/10/74 date well completed  
19 BUTANE GAS CO. OF GREENWOOD firm name  
Leflore county well located

LANDOWNER:  
W.L. Smith  
Money  
(mailing address)

description of formations encountered	from	to
Clay	0	10
Sand	10	90
Sand + Gravel	90	110
Shale	110	250
Sand + Shale	250	450
Clay	450	530
Sand	530	550

WELL LOCATION:  
sec. 25 T 21 N R 1 E  
3 miles E of Money  
(distance) (direction) (nearest town)

WELL PURPOSE: home  
(home, irrigation, municipal, industrial)

- WELL COMPLETION DATA:
- (1) diameter (inches) 2"
  - (2) total depth (feet) 555
  - (3) static water level (feet) 10 below top of ground.
  - (4) casing Steel, 535'  
(material) (depth)  
2" (size) if telescope see back.
  - (5) screen 20' 535'  
(length) (depth to top)  
2" Stainless  
(size) (material)
  - (6) pump 1/2 10  
(HP) (yield gpm)  
Elec  
(type power)
  - (7) electric log  (yes or no)  
(organization running log)
  - (8) how well bottom plugged Back Pressure Valve

DRILLERS REMARKS:


CODED

DISCONTINUED  
DEC 18 1974

MISS. BD. OF WATER COMMISSIONERS

If well telescopes please sketch and show depths.

GROUND LEVEL

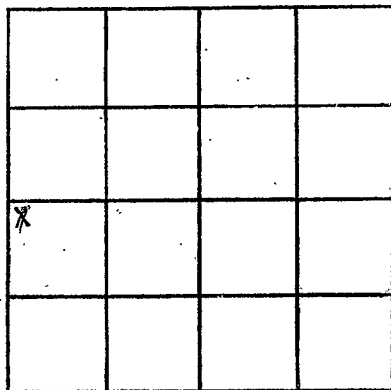

SECTION 21

Please indicate well location X.

ADDITIONAL INFORMATION

If more than one screen, show locations of each on sketch.