

CODED

LEFLORE

E 13


2-6-75

MISSISSIPPI
BOARD OF WATER COMMISSIONERS
416 North State Street
Jackson, Mississippi 39201

WATER WELL DRILLERS LOG


2-6-75 1952 BUTANE GAS CO. OF GREENWOOD Leflore
date well completed firm name county well located

| LANDOWNER: | description of formations encountered | depth | |
|---|--|-------|-----|
| | | from | to |
| Charles Wick | Clay | 0 | 30 |
| Money | SAND | 30 | 70 |
| (mailing address) | SAND + GRAVEL | 70 | 130 |
| WELL LOCATION: | Clay | 130 | 200 |
| sec. 21 T 21 N R 1 E 158 | Green Shale | 200 | 445 |
| 2 miles NE of Money | Clay | 445 | 640 |
| (distance) (direction) (nearest town) | SAND | 640 | 681 |
| WELL PURPOSE: Home | | | |
| (home, irrigation, municipal, industrial) | | | |
| WELL COMPLETION DATA: | | | |
| CODED | | | |
| (1) diameter (inches) 2" | | | |
| (2) total depth (feet) 68' | | | |
| (3) static water level (feet) 15' above | | | |
| top of ground. | | | |
| (4) casing Steel 661' | | | |
| (material) (depth) | | | |
| 2" If telescope see back. | | | |
| (size) | | | |
| (5) screen 20' 661' | | | |
| (length) (depth to top) | | | |
| 2" Stainless | | | |
| (size) (material) | | | |
| (6) pump 1/2 10 | | | |
| (HP) (yield gpm) | | | |
| Elec. | | | |
| (type power) | | | |
| (7) electric log NO | | | |
| (yes or no) | | | |
| (organization running log) | | | |
| (8) how well bottom plugged Back | | | |
| Pressure Valve | | | |
| DRILLERS REMARKS: | | | |
| | | | |
| | | | |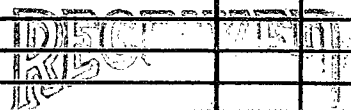
If well telescopes please sketch and show depths.

GROUND LEVEL

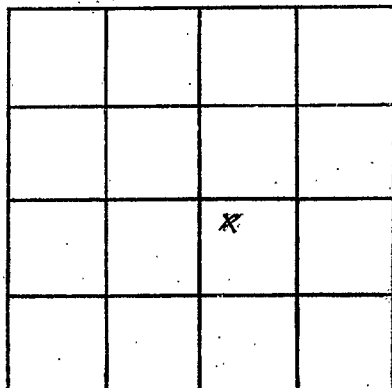

SECTION 21

Please indicate well location X.

ADDITIONAL INFORMATION

If more than one screen, show locations of each on sketch.