

Leflore

E 14

10-18-65

MISSISSIPPI BOARD OF WATER COMMISSIONERS
WATER WELL DRILLERS LOG

CODED

Date: OCT 18, 1965, Driller: DELTA DRILLING County: LEFLORE

(Name)

(1) Owner of Land: S. G. BEAMAN
(Name)

MONEY, MISS.
(Address)

Center of

(2) Location: SE 1/4, 1/4, Sec. 9 TOWNE

_____ miles _____ of _____
(distance) (direction) (Nearest Town)

(3) Topography: _____
(Hilly) (Flat) (Level)

(4) Purpose of Well: Domestic
(Domestic Irrigation
Municipal, Industrial, Other)

Information upon completion of well:

(1) Diameter 3 inches.

(2) Total Depth 730 feet.

(3) Water Level FLOWS feet below top of ground.

(4) Cased to 730, Size 500 1/2" 230 1/2"

(5) Screen: Size 2", Length 20

(6) Were any formations sealed against pollution?

_____ yes, _____ no.


If YES depth of formation _____

Why _____

Drillers Remarks: 20' LAP OF 2"

IN 3" well

Description & Color of Materials Sand, Clay, Red Clay, Shell, etc.	Thick- ness Feet	Depth Feet
Top Soil + SAND	32	32
gravel	76	108
gumbo	22	130
Sand	21	151
gumbo	82	233
green CODED w/rock	31	264
Shale	23	287
green sand w/rocks	80	367
Shale	11	378
gumbo	12	390
green sand	64	454
Shale	50	504
gumbo	20	524
green sand	24	548
Shale	38	586
gumbo	15	601
Sand	33	634
Shale	32	666
Sand	53	719
Shale	11	730

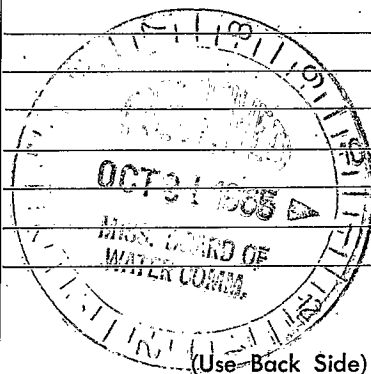

Well No.

