

Leflore

E17

9-66

MISSISSIPPI BOARD OF WATER COMMISSIONERS

WATER WELL DRILLERS LOG

9/26/66
C 2289
CODED

Date: Sept. 15, 1966, Driller: Layne-Central Company County Leflore
(When well drilled) (Name) (Where well is located)

1) Owner of Land: Leflore County School
(Name)
Money, Mississippi
(Address)

2) Location: 1/4, 1/4, Sec. 29 T21N R1E
miles School, of Money
(distance) (direction) (Nearest Town)

3) Topography: flat
(Hilly) (Flat) (Level)

4) Purpose of Well: domestic
(Domestic Irrigation
Municipal, Industrial, Other)

Description & Color of Materials Sand, Clay, Red Clay, Shell, etc.	Thick- ness Feet	Depth Feet
Clay	12	12
Sand	5	17
Coarse sand & pea gravel	15	32
Fine sand	33	65
Fine sand, strks. blue clay	11	76
Coarse sand	12	88
Coarse sand & gravel	36	124
Clay	24	148
Sand	16	164
Clay	30	194
Sand	29	223
Clay	29	252
Hard shale	19	271
Sandy shale	19	290
Sand & shale strks.	33	323
Hard rock	2	325
Shale	13	388
Green sand	24	362
Sandy shale, strks. rock	22	384
Green sand	14	398
Sandy shale	21	419
Hard rock	1	420
Sandy shale	26	446
Sand	19	465
Sand & shale strks.	62	527
Sand	16	543
Shale	20	663
Sand	35	698
Shale	3	707
Sand	8	745
Shale	10	755

Information upon completion of well:

1) Diameter 8x4 inches.

2) Total Depth 757' 9" feet.

3) Water Level 13' 8" feet below top of ground.
171' 72 8"

4) Cased to 550' 2", Size 4"
14' Lap

5) Screen: Size 4", Length 42' 2"

6) Were any formations sealed against pollution?
yes yes, no no.


Why Cemented casing, mechanical seal & B.P.V.

Drillers Remarks: 749
42

Yield in gpm: 709

Size pump:

Type power:

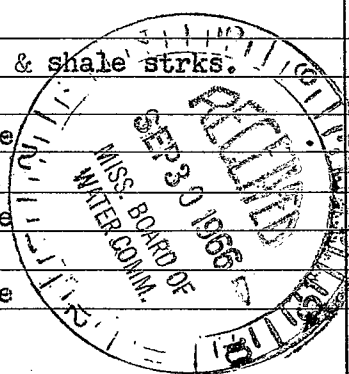

Mail this copy to Board of Water Commissioners 429 Miss. St. Jackson, Miss.

