

MISSISSIPPI
 BOARD OF WATER COMMISSIONERS
 416 North State Street
 Jackson, Mississippi 39201

CODED

WATER WELL DRILLERS LOG

Leflore
EIR
2-67

2-1-67 19 BUTANE GAS Co. of G'wood Leflore
 date well completed firm name county well located

LANDOWNER: J.J. GARY
Wildwood Plantation
Greenwood, Miss.
 (mailing address)

WELL LOCATION:
 sec. 32 T 21 N R 1 E
 S 4W
1/8 miles S of Money
 (distance) (direction) (nearest town)

description of formations encountered	from	to
CLAY	0	10
SAND + GRAVEL	10	120
SHALE	120	280
SAND + SHALE	280	585
CLAY	585	700
WHITE SAND	700	765

CODED

WELL PURPOSE: HOME
 (home, irrigation, municipal, industrial)

WELL COMPLETION DATA:

(1) diameter (inches) 4 3/4"

(2) total depth (feet) 765

(3) static water level (feet) 10 below above top of ground.

(4) casing Steel, 735,
 (material) (depth)
4 x 2 1/2 if telescope see back.
 (size)


(5) screen 30, 735
 (length) (depth to top)
2", STAINLESS STEEL
 (size) (material)

(6) pump 2 45
 (HP) (yield gpm)
Elec.
 (type power)

(7) electric log NO
 (yes or no)

 (organization running log)

(8) how well bottom plugged BRASS
BACK WASH VALVE

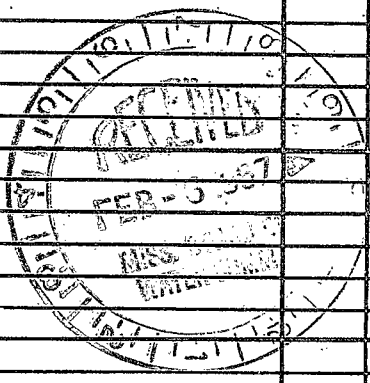

DRILLERS REMARKS:

