

MISSISSIPPI DEPARTMENT OF NATURAL RESOURCES

GW8390 Bureau of Land and Water Resources

Southport Mall

P.O. Box 10631

Jackson, Mississippi 39209

WATER WELL DRILLERS LOG

Permit Applied For

~~LEPROCK~~  
E. Cole

3-2 date well completed

88 Dyer Well firm name

Leblond county well located

LANDOWNER: Tapelo Pkt  
Rt 1 Box E 74  
Schlater Ms.  
(mailing address)

description of formations encountered	from	to
Clay	0	28
fine sand	28	60
M. sand + gravel	60	75
Sand + gravel	75	105

1288B WELL LOCATION:  
sec. 7 T. 21 N R. 1  
3 miles W of Money  
(distance) (direction) (nearest town)

WELL PURPOSE: irrigation  
(home, irrigation, municipal, industrial)

WELL COMPLETION DATA:

- (1) diameter (inches) 16"
- (2) total depth (feet) 105'
- (3) static water level (feet) \_\_\_\_\_ below/above top of ground.
- (4) casing steel (material), \_\_\_\_\_ (depth),  
16 (size) if telescope see back.
- (5) screen 40 (length), \_\_\_\_\_ (depth to top),  
16 (size), \_\_\_\_\_ (material)
- (6) pump 60 (HP), \_\_\_\_\_ (yield gpm),  
Gear (type power)
- (7) electric log No (yes or no),  
None (organization running log)
- (8) how well bottom plugged Plate

1.5' 23' 90'

RECEIVED


MAY 02 1985

Department of Natural Resources  
Bureau of Land & Water Resources

DRILLERS REMARKS:

If well telescopes please  
sketch and show depths.

GROUND LEVEL

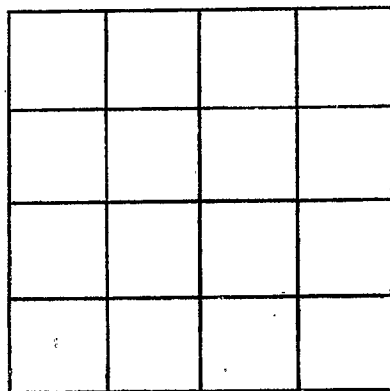

SECTION \_\_\_\_\_

Please indicate well location X.

ADDITIONAL INFORMATION

If more than one screen,  
show locations of each on sketch.