

LEFLORE  
E30  
10/4/78

MISSISSIPPI  
BOARD OF WATER COMMISSIONERS  
416 North State Street  
Jackson, Mississippi 39201

CODED

WATER WELL DRILLERS LOG

October 4, 1978 Dyer Well + Irr. Leflore  
date well completed firm name county well located

LANDOWNER: Miller Bush  
Sunnyside, Miss.  
(mailing address)

description of formations encountered	from	to
Clay	0	13
Clay	13	23
Clay + Fine Sand	23	33
Fine Sand	33	43
Fine Sand	43	53
Fine Sand + Gravel	53	63
Sand + Gravel	63	73
Sand + Gravel	73	83
Sand + Gravel	83	93
Sand + Gravel	93	102
Rock		

WELL LOCATION:  
sec. 30 T4N R1E S  
3 miles East of Sunnyside  
(distance) (direction) (nearest town)

WELL PURPOSE: Irrigation  
(home, irrigation, municipal, industrial)

- WELL COMPLETION DATA:
- (1) diameter (inches) 16"
  - (2) total depth (feet) 102'
  - (3) static water level (feet) 17' below above top of ground.
  - (4) casing Steel, 162' (material) (depth)  
16" (size) if telescope see back.
  - (5) screen 40' length, 62' depth to top  
16" size, Steel material
  - (6) pump 14-4 skic. 2600 (HP) (yield gpm)  
Diesel (type power)
  - (7) electric log No (yes or no)  
(organization running log)
  - (8) how well bottom plugged Plate


REGISTERED  
NOV - 6 1978

MISS. BD. OF WATER COMM.

DRILLERS REMARKS:

If well telescopes please sketch and show depths.

GROUND LEVEL

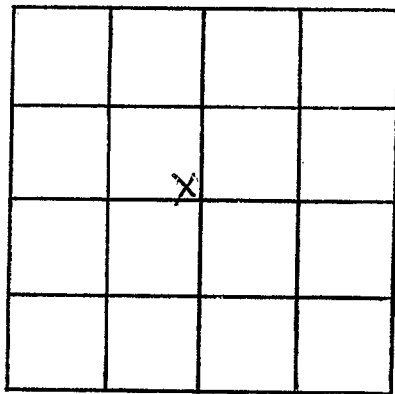

SECTION 30

Please indicate well location X.

ADDITIONAL INFORMATION

Lined area for additional information.

If more than one screen, show locations of each on sketch.