

Leflore  
E 31  
5-12-80

MISSISSIPPI  
 BOARD OF WATER COMMISSIONERS  
 416 North State Street  
 Jackson, Mississippi 39201  
**WATER WELL DRILLERS LOG**

**CODED**

May 12 19 80 Bruce Berryman LEFLORE  
 date well completed Greenwood, Mississippi county well located

LANDOWNER: Jerry Whitfield	description of formations encountered	from	to
Rt. 1. Box 103,	Clay	0	20
Itta Bena. MS 38941	Sand	20	60
(mailing address)	Sand & Gravel	60	100

**WELL LOCATION:**

sec. 25 T. 21 N R. 1 E  
4 miles E of MONEY  
 (distance) (direction) (nearest town)

**CODED**

**WELL PURPOSE:** HOME  
 (home, irrigation, municipal, industrial)

**WELL COMPLETION DATA:**

- (1) diameter (inches) 4"
- (2) total depth (feet) 100 ft.
- (3) static water level (feet) 18 <sup>below</sup> ~~80 ft.~~  
 top of ground.
- (4) casing P.V.C., 80 ft.  
 (material) (depth)  
         If telescope see back.  
 (size)
- (5) screen 20', 80'  
 (length) (depth to top)  
4" .010 P.V.C.  
 (size) (material)
- (6) pump 1 1/2 35  
 (HP) (yield gpm)  
Electric  
 (type power)
- (7) electric log NO  
 (yes or no)  
          
 (organization running log)
- (8) how well bottom plugged PVC Cap.

DEPT. OF NATURAL RESOURCES  
 BUREAU OF LAND & WATER RESOURCES


SEP 30 1980

**RECEIVED**

DRILLERS REMARKS:

If well telescopes please sketch and show depths.

GROUND LEVEL

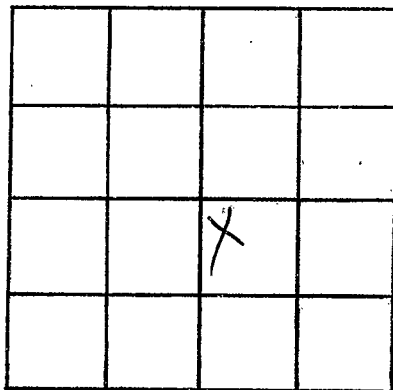

SECTION 25

Please indicate well location X.

ADDITIONAL INFORMATION

If more than one screen,  
show locations of each on sketch.