

MISSISSIPPI DEPARTMENT OF NATURAL RESOURCES

Bureau of Land and Water Resources

Southport Mall

P.O. Box 10631


Jackson, Mississippi 39209 **CODED**

WATER WELL DRILLERS LOG

LeFlore
E32
4-29-81

4-29-81 19 BUTANE GAS COMPANY LeFlore
date well completed OF GREENWOOD county well located

LANDOWNER:	description of formations encountered	from	to
<u>ANNA PEG CORP.</u>			
<u>Winter City</u> (mailing address)	<u>Sand + Clay</u>	<u>10</u>	<u>50</u>
WELL LOCATION:	<u>Sand + Pea Gravel</u>	<u>50</u>	<u>80</u>
sec. <u>5</u> T <u>21</u> N R. <u>8</u> E <u>W</u>	<u>Sand + Gravel</u>	<u>80</u>	<u>104</u>
<u>4</u> miles <u>S</u> of <u>Phillip</u>			
(distance) (direction) (nearest town)			
WELL PURPOSE: (home, irrigation, municipal, industrial)			
WELL COMPLETION DATA:			
(1) diameter (inches) <u>16</u>			
(2) total depth (feet) <u>104</u>			
(3) static water level (feet) <u>25</u> below top of ground.			
(4) casing <u>Steel</u> , <u>64</u> (material), (depth)			
<u>16</u> (size) if telescope see back.			
(5) screen <u>40</u> , <u>64</u> (length), (depth to top)			
<u>16</u> , <u>Steel</u> (size), (material)			
(6) pump <u>200</u> , <u>2,000</u> (HP), (yield gpm)			
<u>Diesel</u> (type power)			
(7) electric log <u>No</u> (yes or no)			
(organization running log)			
(8) how well bottom plugged <u>Steel plate</u>			
DRILLERS REMARKS:			

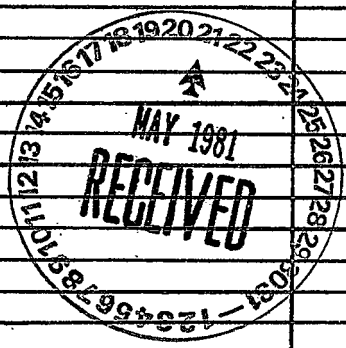

If well telescopes please sketch and show depths.

GROUND LEVEL.

		X	

SECTION 5

Please indicate well location X.

ADDITIONAL INFORMATION

If more than one screen, show locations of each on sketch.