

Leflore
E33
4-15-81

MISSISSIPPI DEPARTMENT OF NATURAL RESOURCES
 Bureau of Land and Water Resources
 Southport Mall
 P.O. Box 10631
 Jackson, Mississippi 39209
WATER WELL DRILLERS LOG

CODED


GW
341

4-15- 19 *81*
 date well completed

Dyer
 firm name


Leflore
 county well located

LANDOWNER:	description of formations encountered	from	to
<i>Weir</i>	<i>clay</i>	<i>0</i>	<i>19</i>
<i>Money, MS.</i> (mailing address)	<i>fine sand</i>	<i>19</i>	<i>42</i>
WELL LOCATION: sec. <i>35</i> T <i>21</i> N R <i>1</i> E <i>3</i> miles <i>E</i> of <i>Money</i> (distance) (direction) (nearest town)	<i>fine-med. sand</i>	<i>42</i>	<i>53</i>
WELL PURPOSE: (home, irrigation, municipal, industrial)	<i>med. sand & gravel</i>	<i>53</i>	<i>84</i>
WELL COMPLETION DATA:	<i>Sand & Gravel</i>	<i>84</i>	<i>113</i>
(1) diameter (inches) <i>16"</i>	CODED		
(2) total depth (feet) <i>113'</i>			
(3) static water level (feet) <i>21</i> below above top of ground.			
(4) casing <i>16"</i> (<i>113'</i>) (material) (depth) <i>16"</i> if telescope see back. (size)			
(5) screen <i>40</i> (<i>73'</i>) (length) (depth to top) <i>16"</i> (<i>Steel</i>) (size) (material)			
(6) pump <i>60</i> (<i>1200</i>) (HP) (yield gpm) <i>Diesel</i> (type power)			
(7) electric log _____ (yes or no) (organization running log)			
(8) how well bottom plugged <i>plate</i>			
DRILLERS REMARKS:			

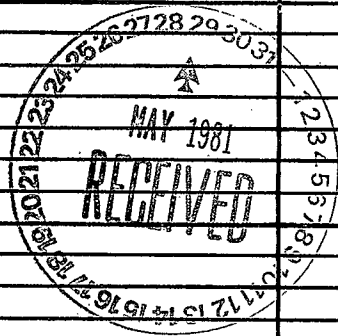

If well telescopes please sketch and show depths.

GROUND LEVEL

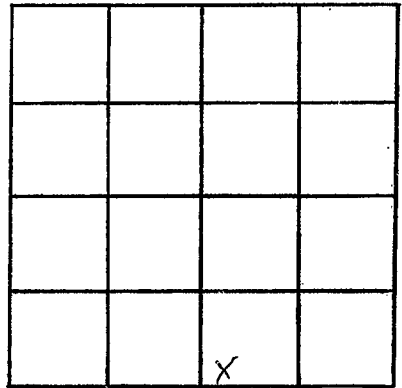

SECTION 35

Please indicate well location X.

ADDITIONAL INFORMATION

If more than one screen, show locations of each on sketch.