

Le Flore  
E 34  
6-27-81

MISSISSIPPI DEPARTMENT OF NATURAL RESOURCES  
Bureau of Land and Water Resources  
Southport Mall  
P.O. Box 10631  
Jackson, Mississippi 39209  
WATER WELL DRILLERS LOG

Barrow?

CODED

June 27 1981 Larry's well & pump Le Flore  
date well completed firm name county well located

LANDOWNER: Tribble Farms  
Money, MS.  
(mailing address)

description of formations encountered	from	to
CLAY	0	40
FINE SAND	40	65
COURSE SAND	65	116

WELL LOCATION:  
sec. 28 T 21 N R 1 E  
2 miles NE of Money  
(distance) (direction) (nearest town)

WELL PURPOSE:  
(home, irrigation, municipal, industrial)

WELL COMPLETION DATA:  
(1) diameter (inches) 16"  
(2) total depth (feet) 116'  
(3) static water level (feet) 20 below above top of ground.  
(4) casing Steel, 76'  
(material) (depth)  
(size) if telescope see back.  
(5) screen 40', 76'  
(length) (depth to top)  
1/2", Steel  
(size) (material)  
(6) pump 60, 3000  
(HP) (yield gpm)  
(type power)

(7) electric log No.  
(yes or no)

(organization running log)

(8) how well bottom plugged Steel Plate

DRILLERS REMARKS:

CODED


DEPT. OF NATURAL RESOURCES  
BUREAU OF LAND & WATER RESOURCES

OCT 15 1981

RECEIVED

If well telescopes please sketch and show depths.

GROUND LEVEL

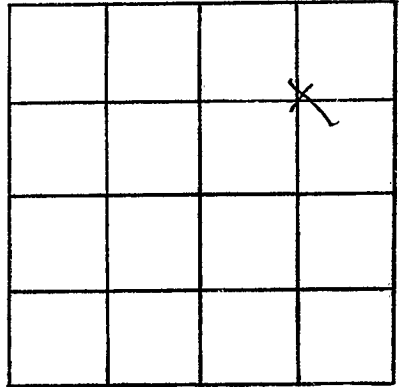

SECTION 28

Please indicate well location X.

ADDITIONAL INFORMATION

If more than one screen,  
show locations of each on sketch.