

MISSISSIPPI DEPARTMENT OF NATURAL RESOURCES

Bureau of Land and Water Resources

Southport Mall

P.O. Box 10631

Jackson, Mississippi 39209

WATER WELL DRILLERS LOG

CODED

*Leflore*  
E 53  
H-

GW  
342

3-2 19 82 *Oyer Well* *Leflore Co.*  
date well completed firm name county well located

LANDOWNER: *Robert Wells*

description of formations encountered	from	to
<i>Clay</i>	<i>0</i>	<i>28</i>
<i>Fine Sand</i>	<i>28</i>	<i>38</i>
<i>Sand</i>	<i>38</i>	<i>44</i>
<i>Sand &amp; Gravel</i>	<i>44</i>	<i>168</i>

(mailing address)

WELL LOCATION:

sec. *21* T *21* N R *1* E  
*35* S W  
*2* miles *E* of *Money*  
(distance) (direction) (nearest town)

WELL PURPOSE:

(home, irrigation, municipal, industrial)

WELL COMPLETION DATA:

- (1) diameter (inches) *16"*
- (2) total depth (feet) *108*
- (3) static water level (feet) *18* below above top of ground.
- (4) casing *Steel*, *68*,  
(material) (depth)  
*16"*  
(size) if telescope see back.
- (5) screen *40'*,  
(length) (depth to top)  
*16"*, *Mild Steel*  
(size) (material)
- (6) pump *60* *3000*  
(HP) (yield gpm)  
*LP*  
(type power)
- (7) electric log *No*  
(yes or no)  
*NONE*  
(organization running log)
- (8) how well bottom plugged *Plate*

DEPT. OF NATURAL RESOURCES  
BUREAU OF LAND & WATER RESOURCES


MAY 14 1982

RECEIVED

DRILLERS REMARKS:

If well telescopes please sketch and show depths.

GROUND LEVEL

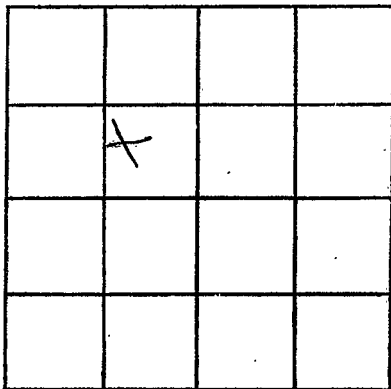

SECTION 27

Please indicate well location X.

ADDITIONAL INFORMATION

If more than one screen,  
show locations of each on sketch.