

MISSISSIPPI DEPARTMENT OF NATURAL RESOURCES

Bureau of Land and Water Resources

Southport Mall

P.O. Box 10631

Jackson, Mississippi 39209

WATER WELL DRILLERS LOG

CODED

Lefflore
E 54

19 1982 *Dreadwell & Inrig.* Lefflore
 date well completed firm name county well located

LANDOWNER: <i>Meller Bush</i>	description of formations encountered	from	to
<i>(for Big D)</i> (mailing address)	<i>C clay Sand & Gravel</i>	<i>0 28</i>	<i>28 100</i>
WELL LOCATION: sec. <u>6-T-21(N)</u> R. <u>1(E)</u> S <u>5</u> miles <u>NW</u> of <u>Money</u> (distance) (direction) (nearest town)			
WELL PURPOSE: (home, irrigation, municipal, industrial)			
WELL COMPLETION DATA:			
(1) diameter (inches) <u>16"</u>			
(2) total depth (feet) <u>100'</u>			
(3) static water level (feet) <u>15'</u> below above top of ground.			
(4) casing <u>steel</u> , <u>16'</u> (material) (depth)			
_____ if telescope see back. (size)			
(5) screen <u>40'</u> , <u>40'</u> (length) (depth to top)			
<u>16"</u> , <u>steel</u> (size) (material)			
(6) pump <u>80</u> <u>1200</u> (HP) (yield gpm)			
<u>diesel</u> (type power)			
(7) electric log <u>no</u> (yes or no)			
_____ <u>no</u> (organization running log)			
(8) how well bottom plugged <u>plate</u>			
DRILLERS REMARKS:			


DEPT. OF NATURAL RESOURCES
 BUREAU OF LAND & WATER RESOURCES

FEB - 3 1983

RECEIVED

If well telescopes please sketch and show depths.

GROUND LEVEL

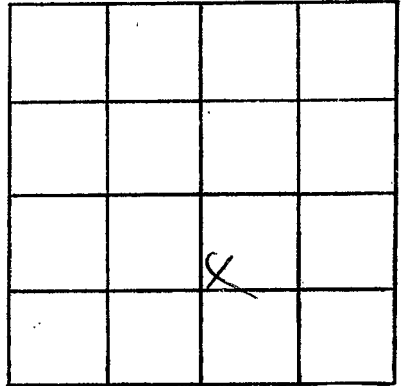

SECTION 6

Please indicate well location X.

ADDITIONAL INFORMATION

If more than one screen,
show locations of each on sketch.